



Section 36 Township 12 Range 10E
Well No. #1 Morris et al
Company Ray Anderson et al

Sec. 36 Twp. 12 R. 10E
Well No. #1 Morris et al Farm
Ray Anderson et al Company
Wakefield - Contr. Contractor

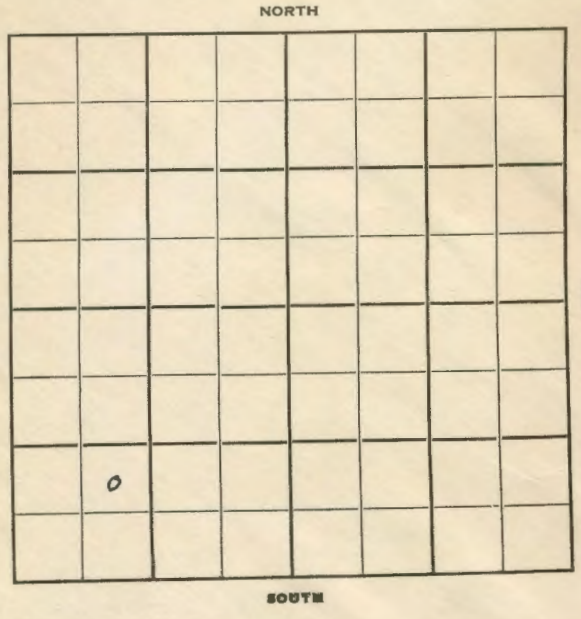

Ft. from N. Line
990' Ft. from S. Line
Ft. from E. Line
990' Ft. from W. Line
NE SW SW

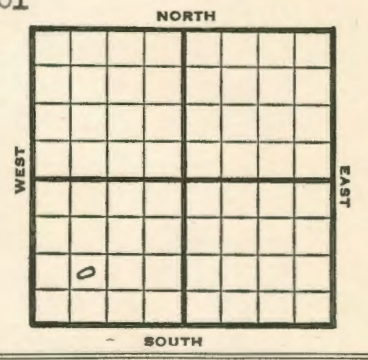

1950	Elev. -	REPORT
10/18	8" @ 129'	Lans. 1250'
		KC 1390'
		BKC 1604'
	Drlg. 1740'	
11/1	Spud 10-12-50	
	D&A TD 3063'	
	8" @ 129'	Lans. 1250'
		KC 1390' BKC 1604'
	Burgess Sand 2259'	Miss 2283'
	Lime 2286'	Kinderhook 2594'
	Hunton 2795'	Maq. 2972'
	Viola 3052'	TD 3063'
	D&A	ABANDONED

