


E 1
 S 25
 12
 10
 Range
 Township
 Section

Johnson
 County
 Jos. H. Brecklein No. 1
 Farm

CSL NESE? Company?
 Sec.

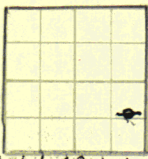

Twp.


6	5	4	3	2	1
7	8	9	X	11	12
18	17	16	15	14	13
19	20	21	22	23	24
30	29	28	27	26	25
31	32	33	34	35	36

Just West of Mission Hills.
 61st. & High Drive.

Elev. _____ T.D. 923'

Date Drilled ?

Correlation by
 Prod - ?

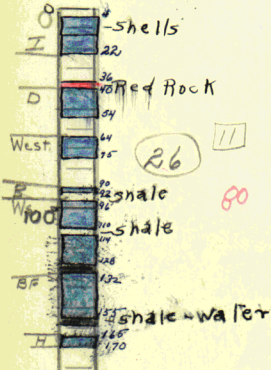

Hertha

200

oil

wayside

300

Red Rock

shale

shale

400

little water

Black

Squirrel

500

Black

600

shale

700

Black

Black (coarse)

Black + Red Rock

Black

Bartlesville

-Black
W.

-Black

800

Fine
shale

900

T.D. - 923'

1000

1100

