

STATE CORPORATION COMMISSION OF KANSAS
OIL & GAS CONSERVATION DIVISIONWELL COMPLETION OR RECOMPLETION FORM
ACO-1 WELL HISTORY

DESCRIPTION OF WELL AND LEASE

Operator: License # 5892
 Name Berentz Drilling Co., Inc.
 Address 115 West Third Street
 P.O. Box 428
 City/State/Zip Eureka, Kansas 67045

Purchaser N/A

Operator Contact Person Kevin F. Hough
 Phone (316) 583-5202

Contractor: License # 5146
 Name Rains & Williamson Co., Inc.

Wellsite Geologist Kenneth Johnson
 Phone

Designate Type of Completion

☒ New Well ☐ Re-Entry ☐ Workover

☐ Oil ☐ SWD ☐ Temp Abd
☐ Gas ☐ Inj ☐ Delayed Comp.
☒ Dry ☐ Other (Core, Water Supply etc.)

If OWWO: old well info as follows:

Operator
 Well Name
 Comp. Date Old Total Depth

WELL HISTORY

Drilling Method:

☒ Mud Rotary ☐ Air Rotary ☐ Cable

12-6-86 12-10-86 12-11-86
 Found Date Date Reached TD Completion Date
 3160'
 Total Depth PBTD

Amount of Surface Pipe Set and Cemented at 328 feet
 Multiple Stage Cementing Collar Used? ☐ Yes ☐ No
 If yes, show depth set.....feet
 If alternate 2 completion, cement circulated
 from.....feet depth to.....w/.....SX cmt

API NO. 15-197-20-198

County Wabaunsee

SE. NW. SE. Sec. 9. Twp. 12S. Rge. 11E ☒ East ☐ West

1700 Ft North from Southeast Corner of Section
 1550 Ft West from Southeast Corner of Section
 (Note: Locate well in section plat below)


Lease Name Meinhardt Well # 1

Field Name Wildcat

Producing Formation N/A

Elevation: Ground 1206' KB 1211'

Section Plat

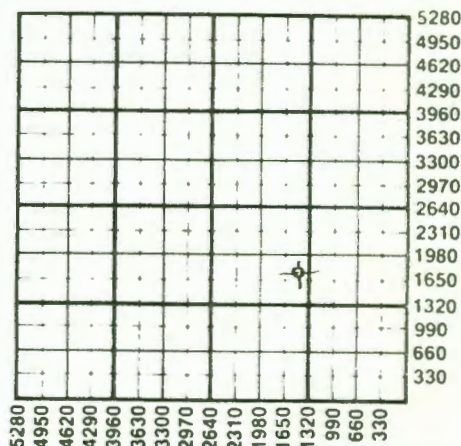

WATER SUPPLY INFORMATION

Disposition of Produced Water: ☐ Disposal
 Docket # ☐ Repressuring

Questions on this portion of the ACO-1 call:

Water Resources Board (913) 296-3717

Source of Water:

Division of Water Resources Permit #

☐ Groundwater.....Ft North from Southeast Corner
 (Well)Ft West from Southeast Corner of
 Sec Twp Rge ☐ East ☐ West

☐ Surface Water.....Ft North from Southeast Corner
 (Stream, pond etc).....Ft West from Southeast Corner
 Sec Twp Rge ☐ East ☐ West

☐ Other (explain).....
 (purchased from city, R.W.D. #)

INSTRUCTIONS: This form shall be completed in duplicate and filed with the Kansas Corporation Commission, 200 Colorado Derby Building, Wichita, Kansas 67202, within 90 days after completion or recompletion of any well. Rule 82-3-130 and 82-3-107 apply.

Information on side two of this form will be held confidential for a period of 12 months if requested in writing and submitted with the form. See rule 82-3-107 for confidentiality in excess of 12 months.

One copy of all wireline logs and drillers time log shall be attached with this form. Submit CP-4 form with all plugged wells. Submit CP-111 form with all temporarily abandoned wells.

9-12-11E Ind

SIDE TWO

Operator Name Berentz Drilling Company, Inc Lease # Name Meinhardt Well # 1

Sec. 9 Twp. 12S Rge. 11E ☒ East ☐ West County Wabaunsee

WELL LOG

INSTRUCTIONS: Show important tops and base of formations penetrated. Detail all cores. Report all drill stem tests giving interval tested, time tool open and closed, flowing and shut-in pressures, whether shut-in pressure reached static level, hydrostatic pressures, bottom hole temperature, fluid recovery, and flow rates if gas to surface during test. Attach extra sheet if more space is needed. Attach copy of log.

Drill Stem Tests Taken ☐ Yes ☒ No
 Samples Sent to Geological Survey ☒ Yes ☐ No
 Cores Taken ☐ Yes ☒ No

Formation Description
☒ Log ☐ Sample

Name	Top	Bottom
Heebner	1063'	
Lansing	1332'	
K.C.	1469'	
Mississippi	2391'	
Kinderhook	2652'	
Hunton	2860'	
Viola	3134'	
T.D.	3160'	

CASING RECORD ☒ New ☐ Used

Report all strings set-conductor, surface, intermediate, production, etc.

Purpose of String	Size Hole Drilled	Size Casing Set (in O.D.)	Weight Lbs/Ft.	Setting Depth	Type of Cement	#Sacks Used	Type and Percent Additives
Surface	12 1/4"	8 5/8"	24#	328'	Common	155	3% c.c.

PERFORATION RECORD

Acid, Fracture, Shot, Cement Squeeze Record

Shots Per Foot	Specify Footage of Each Interval Perforated	(Amount and Kind of Material Used)	Depth

TUBING RECORD Size Set At Packer at Liner Run ☐ Yes ☐ No