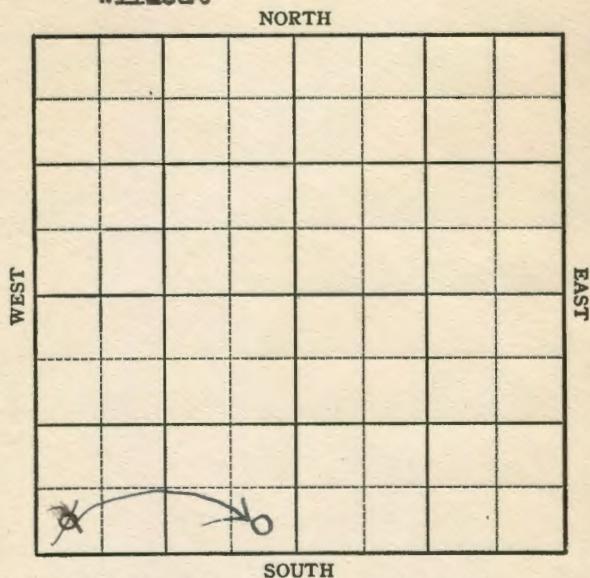


**KANSAS**

15-197-00057

Section 3 Township 12 Range 11-EWell No. #1 StowigCompany Thrifty Drlg et al  
Wildcat**KANSAS**


Wabaunsee

Sec. 3 Twp. 12 R. 11EWell No. 1 Stowig FarmThrifty Drlg. et al CompanyWildcat

Ft. from N. Line

330 Ft. from S. Line330' Ft. from E. Line330 Ft. from W. Line

SW/4 SE SW

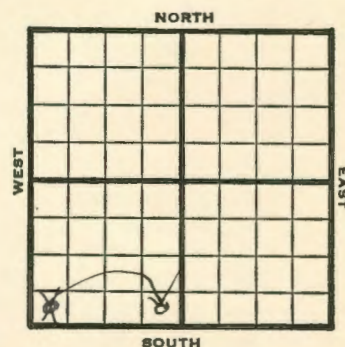

1949

**Elev 1256'** REPORT

8/24

Location

8/31

8" @ 214'

9/7

SD

9/14

"

9/21

**Lans. 1316'****KC 1496'****BKC 1712'****Miss 2450****Drlg. 2728'**

9/28

**TD 3383'****Hunton 2878'****Viola 3160'****Simp 3297'****Arb. 3363'****Aband.****ABANDONED**

L-60

BKC-456

M-1194

L-M 1134

BKC-M 738

1316

1256

60

1712

1256

456

2450

1256

1194

60

1134

1194

456

738

2478  
2450  
283297  
2878  
4193297  
1256  
2041

Wildcat

Kansas

Map No. \_\_\_\_\_ Sec. 3 Twp. 12 R. 11EWell No. 1 Stowig

Thrifty Drlg. etal.

Company

ABANDONED

Contractor

SE SW

## SECTION PLAT

|  |  |  |  |
|--|--|--|--|
|  |  |  |  |
|  |  |  |  |
|  |  |  |  |
|  |  |  |  |
|  |  |  |  |

Ft. from N. Line

330

Ft. from S. Line

330

Ft. from E. Line

Ft. from W. Line

Wabaunsee County

Location

## RECORD

Cased \_\_\_\_\_ in. \_\_\_\_\_ ft.

Sand

Gas

Oil

Total Depth 2983

## PRODUCTION

1st 24 hrs. Nat.

1st 24 hrs. after shot

Gas \_\_\_\_\_ Cu. Ft.

Dry Hole

Abandoned

Date

SEP 28 1949 19

S. J. LEWIS

Scout

Wildcat

Kansas

Map No. \_\_\_\_\_ Sec. 3 Twp. 12 R. 11EWell No. 1 Stowig

Thrifty Drlg. etal.

Company

CORRECTION

Contractor

SE SW

## SECTION PLAT

|  |  |  |  |
|--|--|--|--|
|  |  |  |  |
|  |  |  |  |
|  |  |  |  |
|  |  |  |  |
|  |  |  |  |

Ft. from N. Line

330

Ft. from S. Line

330

Ft. from E. Line

Ft. from W. Line

Wabaunsee County

Location

## RECORD

Rig up

Drilling and Remarks:

Reported

SW/C

Cased \_\_\_\_\_ in. \_\_\_\_\_ ft.

Sand

Gas

Oil

Total Depth

## PRODUCTION

1st 24 hrs. Nat.

1st 24 hrs. after shot

Gas \_\_\_\_\_ Cu. Ft.

Dry Hole

Abandoned

Date

SEP 7 1949 19

S. J. LEWIS

Scout

Wildcat

Map No. \_\_\_\_\_ Sec. 3 Twp. 12 R. 11E

Well No. 1 Stowig

Thrifty Drlg. etal. Company

Contractor

SW/C

**FIRST REPORT  
SECTION PLAT**

\_\_\_\_\_ Ft. from N. Line

330 Ft. from S. Line

\_\_\_\_\_ Ft. from E. Line

330 Ft. from W. Line

|  |  |  |  |
|--|--|--|--|
|  |  |  |  |
|  |  |  |  |
|  |  |  |  |
|  |  |  |  |

Wabaunsee County

Location X

**RECORD**

Cased \_\_\_\_\_ in. \_\_\_\_\_ ft.

Sand \_\_\_\_\_

Gas \_\_\_\_\_

Oil \_\_\_\_\_

Total Depth \_\_\_\_\_

**PRODUCTION**

1st 24 hrs. Nat. \_\_\_\_\_

1st 24 hrs. after shot \_\_\_\_\_

Gas \_\_\_\_\_ Cu. Ft.

Dry Hole \_\_\_\_\_

Abandoned \_\_\_\_\_

Date

AUG 24 1949 19 S. J. LEWIS Scout