

Section 18 Township 12 Range 11E

Well No. #1 A. W. Wolgast

Company Skelly Oil


Sec. 18 Twp. 12 R. 11-E

Well No. #1 A. W. Wolgast Farm

Skelly Oil Company

Contractor

Wildcat
990 Ft. from N. Line
Ft. from S. Line
330 Ft. from E. Line
Ft. from W. Line
SE NE SW

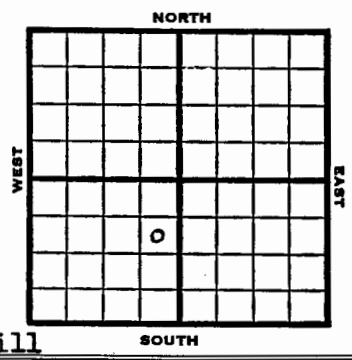

Core Drill

1951 Elev. 1254' **REPORT**

1/3	Location
2/14	Spud 1-10-51 D&A TD 3168 8" @ 195' Howard 728' Top. 791' Lans. 1370' KC 1507' DST 1674-79 opn 1 hr Rec. 8' ocm 1 gal. free oil EKC 1718' Miss 2382' B. Miss 2609' Hunton 2842' DST 2839-52 opn 1 hr Rec. 30' so & gcm Viola 3167-68' opn 1 hr Rec. 110' wtr TD 3168 5" @ 1727' DP 1694 24/1674-85 2000 A S/6 bwph SSO S/4 bo 12 bw S/18 bw 2 bo 6 hr S/2 1/2 bo 27 bw 9hr S/1-3/4 bo 22 bw 8hr. D&A
	ABANDONED

1254
1222
322

1370
1254
116

1718
1254
464

2382
1370
1012

2382
1718
664

NORTH

WEST

EAST

SOUTH

91

