


Map No. KANSAS Sec. 19 Twp. 12 R. 11 E
Well No. 1- Schwalm Farm
Empire G & F Company

_____ Ft. from N. Line

330 Ft. from S. Line

330 Ft. from E. Line

_____ Ft. from W. Line

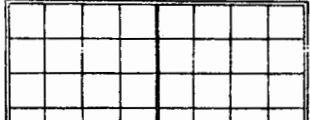

0

1927	
Date	REPORT
6/22	Location
6/29	moving in timbers
7/7	Bldg rig
7/13	
7/20	Rigging up
7/28	Spudding
8/4	Drlg 750'
8/10	fishing 840
8/18	setting 12" - 1500'
8/24	Drlg 2050
9/1	Top line 2485 - H.F.W.
	Drilling 2540-
9/7	" 2636
9/14	" 2675
9/29	Top line 2485 - H.F.W. 2990-
	-2995 - Drlg 3056-
10/6	Drlg 3100-
10/12	" 3265
10/19	fishing 3320
10/27	Top line 2485.
	H.F.W. 2990-95-
	log 3320

11/12 - Top lime 2485
H.F.W. 2990-2995
Log. 3320

11/9 ————— 529618
11/16 —————

11/23 —————

11/30 —————

12/7 —————

12/14 —————

12/21 —————

12/28 —————

1928 —————

1/5 —————

1/11 —————

1/18 —————

1/26 - Top Viola 3382 - Top Wilcox 3400 -
drilling 3406 -

2/2 - Shut down 3431 -

2/9 - Top lime 2485

Top Viola 3382

Top Wilcox 3400

D.R.A. 3438

KANSAS

Map No. Sec. 19 Twp. 12 R. 11

Well No. 1 Ahwalm

Empire S & C Company

Contractor

COMPLETED

SECTION PLAT

Ft. from N. Line

330 Ft. from S. Line

330 Ft. from E. Line

Ft. from W. Line

ABANDONED

			0

Location

Rig up

Drilling and Remarks:

top line 2485

top Viola 3382

top Wilcox 3400

Dta 3438

RECORD

Cased in. ft.

Sand

Gas

Oil

Total Depth 3438

PRODUCTION

1st 24 hrs. Nat.

1st 24 hrs. after shot

Gas Cu. Ft.

Dry Hole

Abandoned

Date

FEB 9 1928

CHAS. L. SHERWOOD

192

Scout

KANSAS

Map No. Sec. 19 Twp. 12 R. 11

Well No. 1 Ahwalm

Empire S & C Company

Contractor

FIRST REPORTS

SECTION PLAT

Ft. from N. Line

330 Ft. from S. Line

330 Ft. from E. Line

Ft. from W. Line

			0

Location

Rig up

Drilling and Remarks:

RECORD

Cased in. ft.

Sand

Gas

Oil

Total Depth

PRODUCTION

1st 24 hrs. Nat.

1st 24 hrs. after shot

Gas Cu. Ft.

Dry Hole

Abandoned

Date

JUN 22 1927

CHAS. L. SHERWOOD

192

Scout