

Map No. 98 Sec. 4 Twp. 12 R. 14E

Map No. 98 Sec. 4 Twp. 12 R. 14E

Well No. 1 W. A. Fritz

Well No. 1 W. A. Fritz

McKnab etal Company

McKnab etal Company

Contractor

Contractor

ABANDONED

FIRST REPORT

SW SE NW

SECTION PLAT

SECTION PLAT

Ft. from N. Line

SW SE NW

Ft. from N. Line

480 Ft. from S. Line

480 Ft. from S. Line

990 Ft. from E. Line

990 Ft. from E. Line

Ft. from W. Line

Ft. from W. Line

WILDCAT

Location

RECORD

Location

RECORD

Cased in., ft.

Cased in., ft.

Rig up

Sand

Rig up

Sand

Drilling and Remarks:

Gas

Drilling and Remarks:

Gas

Wilcox 2632

Oil

Cellar

Oil

2689

Total Depth 2720

Total Depth

PRODUCTION

PRODUCTION

1st 24 hrs. Nat.

1st 24 hrs. Nat.

1st 24 hrs. after shot

1st 24 hrs. after shot

Gas Cu. Ft.

Gas Cu. Ft.

Dry Hole

Dry Hole

Abandoned

Abandoned

Date JUN 21 1939 19

Scout

Date OCT 5 - 1938 19 H. D. Hatfield Scout

*Handwritten scribbles and lines in the top left corner.*


.....
<i>Paul</i>
<i>gro</i>
<i>X</i>
.....
.....
.....
.....

✓

Misc. Small Maps
Cards
Tracing
France Map
Scarborough Map
Moody Map
Geological Dept.
Moody Flat Book


Sec. 4 Twp. 12 R. 14-E  
 Well No. #1 W. A. Fritz Farm  
McKnab et al Company

\_\_\_\_\_ Ft. from N. Line  
480 Ft. from S. Line  
990 Ft. from E. Line  
 \_\_\_\_\_ Ft. from W. Line

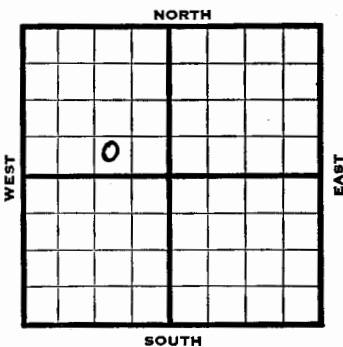

1938	REPORT
10/5	Cellar.
10/14	"
10/21	"
10/28	"
11/4	"
11/12	"
11/18	"
11/25	"
12/2	"
12/9	"
12/15	"
12/23	"
12/30	Mat'l.
1939	
1/6	"
1/13	"
1/20	"
1/27	C. R.
2/3	Spud.
2/10	Mystery well.
2/17	Drlg. 480?
	<b>OVER</b>

Section 4 Township 12 Range 14-E  
 Well No. 1 W. A. Fritz  
 Company McKnab et al

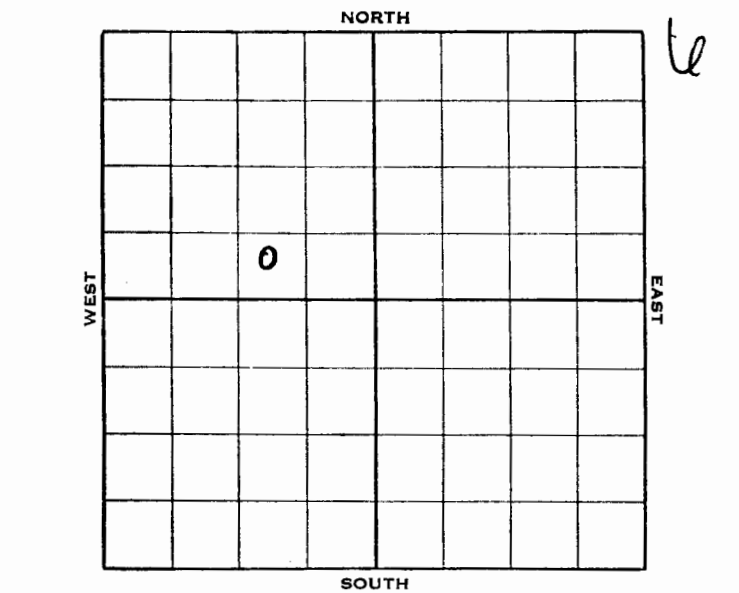

473730

1939  
 2/23 Drlg. 1600' ?  
 3/3 Drlg. 1800' ?  
 3/10 10" - 1136' 8" - 1718'  
 Drlg. 1900'  
 3/16 No dope.  
 3/24 8" - 1901' Chat. 1901'  
 H.F.W. 1960' SD 2160' fog csg.  
 3/31 " " " " " "  
 4/7 " " " " " "  
 4/14 " " " " " "  
 4/21 Hutton 2380' T.D. 2685' H.F.W.  
 Running 6".  
 4/28 " "  
 5/5 " "  
 5/12 " "  
 5/19 " "  
 5/26 " "  
 6/1 " "  
 6/8 " "  
 6/16 T.D. 2700' SD.  
 6/21 Wilcox 2632'  
 Arb. 2689'  
 T.D. 2720'

2380  
 1901  
 479

2632  
 2280  
 252

ABANDONED