


E 21
S 12
15
Range
Township
Section

Leavenworth
County
Collins
Farm
No. 1
?
Company



Twp.	
6	5
7	8
16	17
18	19
30	29
31	32

Loc C 7 1/2 S E
Elev. 2827 L.T.S. 1040.
Date Drilled ?
Correlation by
Pro ?

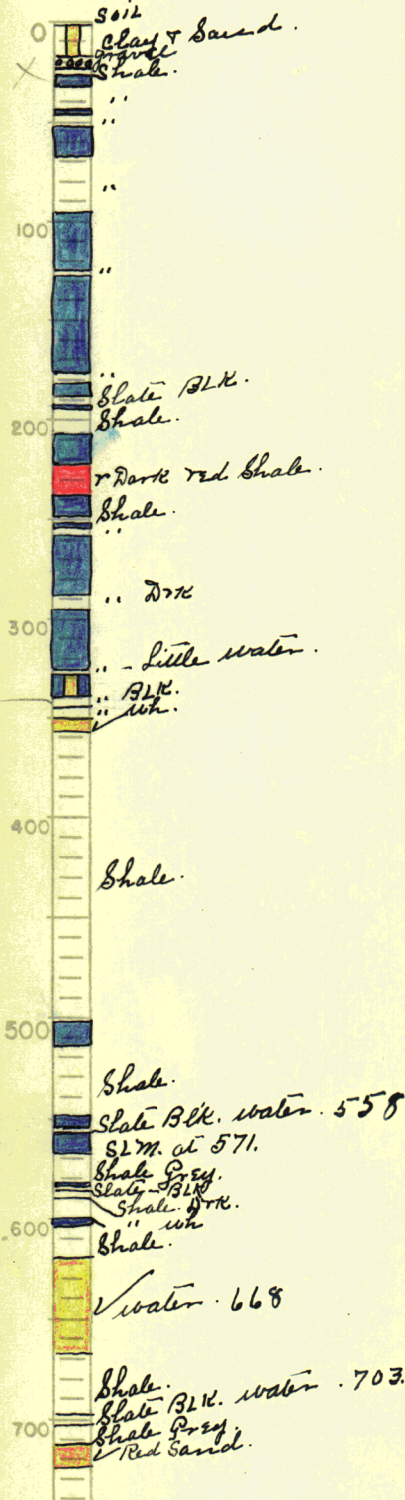



Shale.

Shale.

Shale.

Shale. B212. water 1012

Shale

Shale.

T.D. 1040

1036
 827

 209

Lime was showing
 at 1037 ft.
 well Plugged by Sears.
 District Plugger on
 9-5-39.
 Drilled to 1040.
 into Miss Lime