


Pool Name Wildcat
 Map No. MM Sec. 10 Twp. 12 R. 17E
 Well No. 1 Milikan
Milikan etal. Company

ABANDONED Contractor

C W L NW SE

SECTION PLAT

660 Ft. from N. Line
 _____ Ft. from S. Line
 _____ Ft. from E. Line
330 Ft. from W. Line

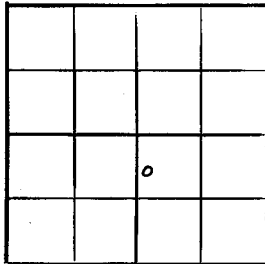

Shawnee County

Location	RECORD
Rig up	Cased _____ in. _____ ft.
Drilling and Remarks:	Sand _____
<u>Cur 2408</u>	Gas _____
<u>Nochwise</u>	Oil _____
	Total Depth <u>2511</u>
	PRODUCTION
	1st 24 hrs. Nat. _____
	1st 24 hrs. after shot _____
	Gas _____ Cu. Ft.
	Dry Hole _____
	Abandoned _____

Date

APR 26 1944 19 S. J. LEWIS Scout

Shawnee


Pool Name Wildcat
 Map No. MM Sec. 10 Twp. 12 R. 17E
 Well No. 1 Milikan
Milikan etal. Company

CORRECTION Contractor

C W L NW SE

SECTION PLAT

660 Ft. from N. Line
 _____ Ft. from S. Line
 _____ Ft. from E. Line
330 Ft. from W. Line

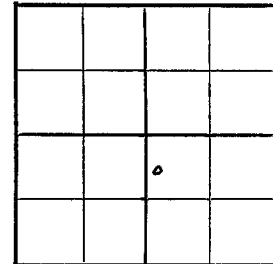

Wildcat

Location	RECORD
Rig up	Cased _____ in. _____ ft.
Drilling and Remarks:	Sand _____
<u>Reported as</u>	Gas _____
<u>Alexander etal.</u>	Oil _____
	Total Depth _____
	PRODUCTION
	1st 24 hrs. Nat. _____
	1st 24 hrs. after shot _____
	Gas _____ Cu. Ft.
	Dry Hole _____
	Abandoned _____

Date

APR 12 1944 19 S. J. LEWIS Scout

no wall

no wall

No Small Map

Madge	
Tracing	
Franca Map	
Scarborough Map	X
Moody Map	
Geological Dept.	
Moody Plat Book	

No Small Map - One

Misc. Small Maps	
Cards	<i>Madge</i>
Tracing	
Franca Map	
Scarborough Map	X
Moody Map	
Geological Dept.	
Moody Plat Book	

Map No. MM Sec. 10 Twp. 12 R. 17EWell No. 1 MilikanAlexander etal.

Company

FIRST REPORT

Contractor


C W L NW SE

SECTION PLAT

660 Ft. from N. Line

Ft. from S. Line

Ft. from E. Line

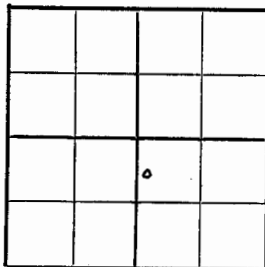330 Ft. from W. Line

Wildcat

Location

Rig up

Drilling and Remarks:

Surface Hole

RECORD

Cased _____ in., _____ ft.

Sand _____

Gas _____

Oil _____

Total Depth _____

PRODUCTION

1st 24 hrs. Nat. _____

1st 24 hrs. after shot _____

Gas _____ Cu. Ft.

Dry Hole _____

Abandoned _____

Date

APR 5 1944 19

S. J. LEWIS Scout

Sec. 10 Twp. 12 R. 17EWell No. #1 Milikan FarmMILIKANAlexander etal.


Company

Wildcat

660 Ft. from N. Line

Ft. from S. Line

Ft. from E. Line

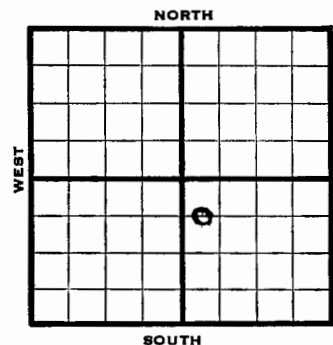330 Ft. from W. Line

1944

Et.

1120

REPORT

4/5

Surface Hole

4/12

10" @ 40
Lans 608
BKC 961
Miss 1714
TD 1890
SD

4/19

B. Miss 2017
Hunton 2112
Viola 2226
Simp 2348
Arb 3408
Drlg. 2480

4/26

Arb 2408
TD 2511
No shows.


ABANDONED

2112
1714
392

1120
2511
392

FORM 51-EMPTROL

Company MILIKAN
Alexander et al

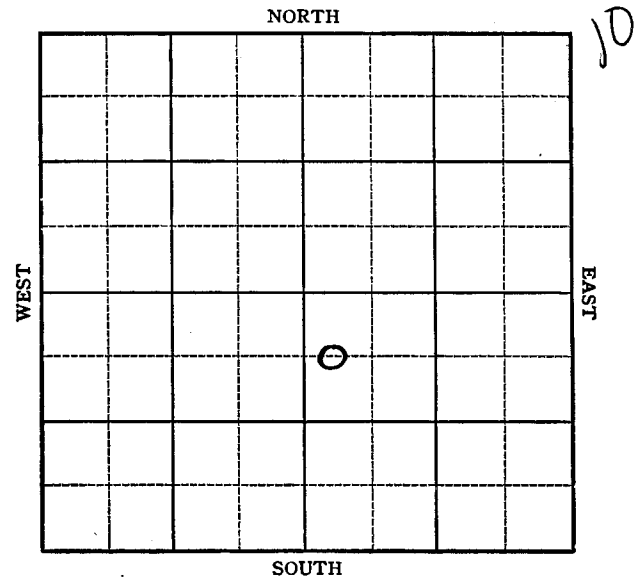

50 Small Map. Omaha
mudge
Geological Dept.
Pierce Plat Book