


Map No. **KANJAS** Sec. **34^S** Twp. **12^S** R. **2^E**

Well No. **1 - Stone** Farm

Sunclair - Ritchey Company

NORTH

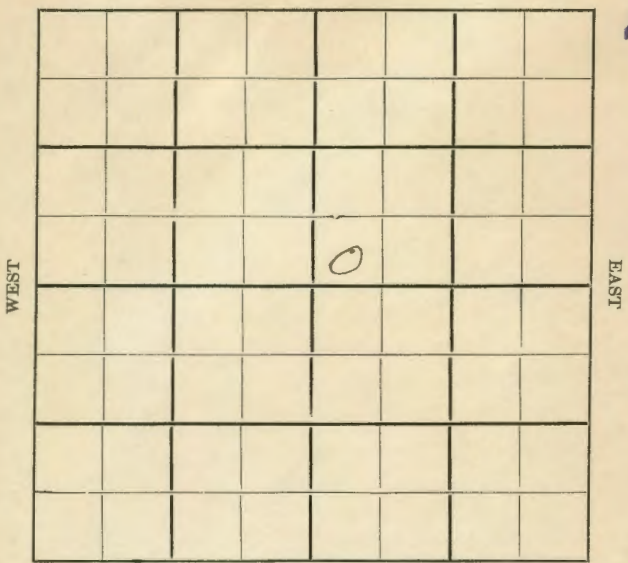

SOUTH

Location.....

Drilling Remarks.....

Rig Up.....

Drilling Remarks.....

RECORD

Cased..... in..... ft.

Sand.....

Gas.....

Oil.....

Total Depth.....

PRODUCTION

1st 24 hrs. Nat.....

1st 24 hrs. after shot.....

Gas..... cu. ft.....

Dry Hole.....

Abandoned.....

Map No..... Sec..... Twp..... R.....

Well No..... Farm


Company

..... Ft. from N. Line

..... Ft. from S. Line

..... Ft. from E. Line

..... Ft. from W. Line

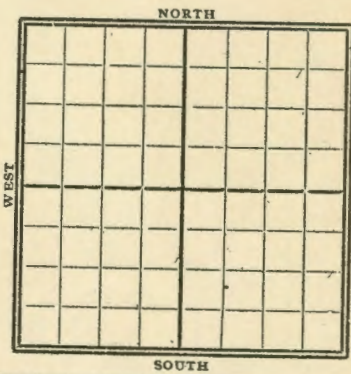

Date

REPORT

Gypsy Roads

5/10 Rain bars show 2320'

Abd T'D 2803'

(40) MAP No. _____ Sec. 34 TWP. 12S R. 2E

WELL No. 1 Stone

Archer - Ritchey COMPANY

CONTRACTOR

*Our well map
don't cover*

SECTION PLAT

_____ FT. FROM N. LINE

_____ FT. FROM S. LINE

_____ FT. FROM E. LINE

_____ FT. FROM W. LINE

LOCATION _____

RIG UP _____

DRILLING AND REMARKS:

*Had re-interview
show at 2320*

RECORD

CASED _____ IN. _____ FT.

SAND _____

GAS _____

OIL _____

TOTAL DEPTH 2803

PRODUCTION

1ST 24 HRS. NAT. _____

1ST 24 HRS. AFTER SHOT _____

GAS _____ CU. FT.

DRY HOLE

ABANDONED

DATE

5/10 1920 SCOUT