


KANSAS

Leavenworth

Section 15 Township 12 Range 20E

Well No. 1 Little Hill

Company Long Zuick 867

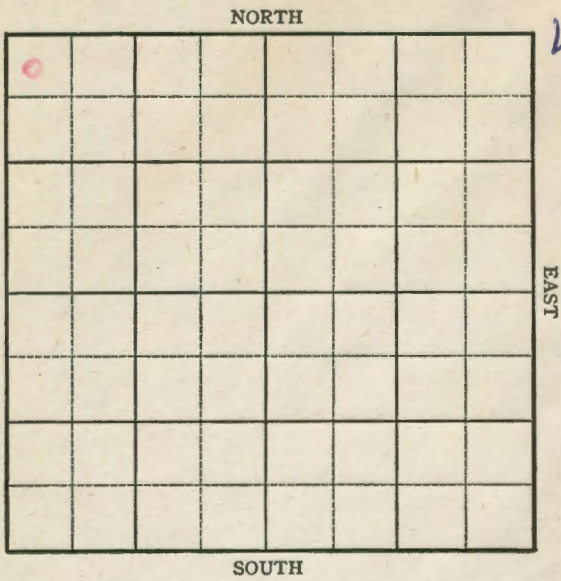

KANSAS

Leavenworth

Sec. 15 Twp. 12 R. 20-E

Well No. #1 Little Hill Farm


Long Zuick Company

330 Ft. from N. Line

_____ Ft. from S. Line

_____ Ft. from E. Line

330 Ft. from W. Line

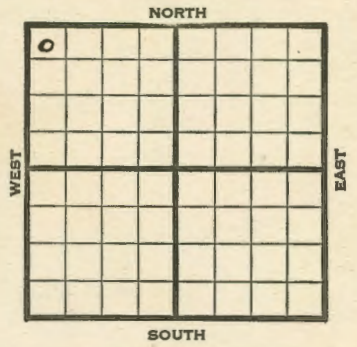

NW/c

1945

Elev. 1867

REPORT

8/1

Drlg. 30'

~~8/8~~

" "

8/15

" "

8/22

Miss. 1210

TD 1214'

ABANDONED

KANSAS

Kansas Pool Name McLouth

Map No. 20 Sec. 15 Twp. 12 R. 20E

Well No. 1 Little Hill

Long Zuick Company

ABANDONED Contractor

NW/c

E1867
SECTION PLAT

330 Ft. from N. Line

0			

Ft. from S. Line

Ft. from E. Line

330 Ft. from W. Line

Leavenworth County

Location _____

RECORD

Cased _____ in., _____ ft.

Sand _____

Gas _____

Oil _____

Total Depth 1214

PRODUCTION

1st 24 hrs. Nat. _____

1st 24 hrs. after shot _____

Gas _____ Cu. Ft.

Dry Hole _____

Abandoned _____

Date

AUG 22 1945 19

S. J. LEWIS Scout

KANSAS

Kansas Pool Name McLouth

Map No. 20 Sec. 15 Twp. 12 R. 20E

Well No. 1 Little Hill

Long Zuick Company

FIRST REPORT Contractor

NW/c

SECTION PLAT

330 Ft. from N. Line

0			

Ft. from S. Line

Ft. from E. Line

330 Ft. from W. Line

Leavenworth County

Location _____

RECORD

Cased _____ in., _____ ft.

Sand _____

Gas _____

Oil _____

Total Depth _____

PRODUCTION

1st 24 hrs. Nat. _____

1st 24 hrs. after shot _____

Gas _____ Cu. Ft.

Dry Hole _____

Abandoned _____

Date

AUG 1 1945 19

S. J. LEWIS Scout