


KANSAS
FORM 50-100 PETROL

Douglas

Section 33 Township 12 Range 20 E

Well No. #1 Community

Company Huber Oil Corp. *816*

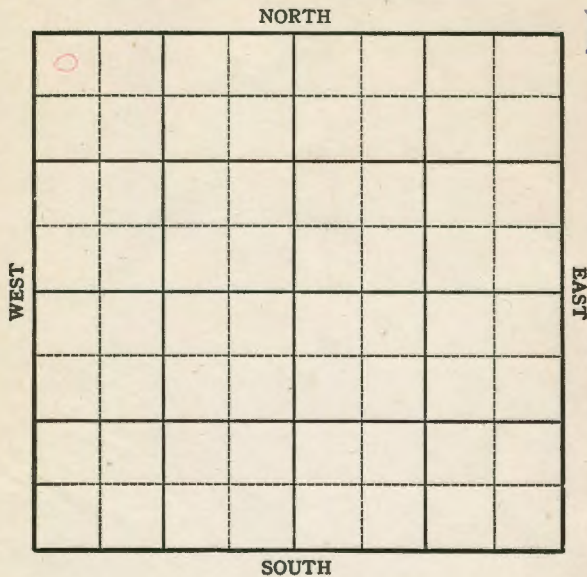

FORM 252-A

KANSAS

Douglas

Sec. 33 Twp. 12 R. 20-E

Well No. #1 Community Farm

Huber Oil Corp. Company


(Wildcat)

330 Ft. from N. Line

_____ Ft. from S. Line

_____ Ft. from E. Line

330 Ft. from W. Line

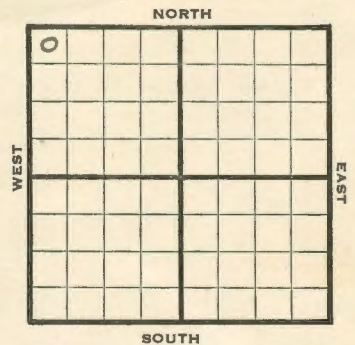

1944 REPORT

5/17	Machine
5/24	"
5/31	"
6/7	Spud.
6/15	16" @ 441 55' Run 12" To much water
6/21	13" @ 50' Lans 52' B KC 381 Drlg. 440
6/28	Drlg 550
7/12	550 SD
7/19	" "
7/26	Squirrel sd 670 325,000 Gas 685-700 SO 713-16 Drlg. 855
8/2	Miss. 1089' Drlg. 1119
8/9	8" @ 1100 SD
8/16	" " " "
8/23	Drlg. 1250
8/30	Drlg. 1277
9/8	B Miss 4488 Drlg. 1490
9/13	B Miss 1507 corrected. 6" @ 1512' Viola 1551' 1554' NR 6"

$$\begin{array}{r} 1735 \\ 1557 \\ \hline 178 \end{array}$$

$$\begin{array}{r} 1735 \\ 816 \\ \hline 919 \end{array}$$

$$\begin{array}{r} 1557 \\ 1089 \\ \hline 468 \end{array}$$

529605

1944

9/21 Hunton 1557 corrected
 Viola 1626
 1628 NR 5"
 9/28 6" @ 1632 Drlg. 1705
 10/4 St. Peter 1735 HFW
 Arb 1797
 TD 1813 No shows PB
 10/11 PB 710 6" @ 674 CO
 10/18 Wtr. PB 700
 10/25 PB 698
 50 qts 687-97 2000 acid
 11/2 " " " " " "
 11/8 " " " " " "
 11/16 " " " " " "
 11/24 " " " " " "
 12/29 PB 3694 WOC
 12/6 " " "
 2/14 " " "
 2/21 " " "
 2/29 " " "
 945
 7/3 1½ qts 685-95 250 acid
 2 qts 685-95 ; 98,000 Cu ft gas
 1/10 " " " " " " "
 1/17 " " " " " " "
 1/26 " " " " " " "
 1/31 Squirrell Sd 670
 Arb. 1797
 TD 1813
 PB 674
 Gas 400,000

COMPLETED

Pool Name WildcatMap No. 111 Sec. 33 Twp. 12 R. 20EWell No. 1 Community

Huber Oil Corp. Company

COMPLETED Contractor

NW/c

SECTION PLAT

330 Ft. from N. Line

Ft. from S. Line

Ft. from E. Line

330 Ft. from W. Line

0			

Douglas

Location

Rig up

Drilling and Remarks:

*Squiss 6. Set 670**Act 1792**PA 624**400,000 Gas*

RECORD

Cased in, ft.

Sand

Gas

Oil

Total Depth 1813

PRODUCTION

1st 24 hrs. Nat.

1st 24 hrs. after shot

Gas Cu. Ft.

Dry Hole

Abandoned

Date

JAN 31 1945

19

S. J. LEWIS

Scout

Pool Name WildcatMap No. 111 Sec. 33 Twp. 12 R. 20EWell No. 1 Community

Huber Oil Corp. Company

FIRST REPORT Contractor

NW/c

SECTION PLAT

330 Ft. from N. Line

Ft. from S. Line

Ft. from E. Line

330 Ft. from W. Line

0			

Douglas County

Location

Rig up

Drilling and Remarks:

Machine

RECORD

Cased in, ft.

Sand

Gas

Oil

Total Depth

PRODUCTION

1st 24 hrs. Nat.

1st 24 hrs. after shot

Gas Cu. Ft.

Dry Hole

Abandoned

Date

MAY 17 1944

19

S. J. LEWIS

Scout