

P1

State Geological Survey
WICHITA BRANCH

AFFIDAVIT OF COMPLETION FORM

6-12-22E

ACO-1

D
Dry

This form shall be filed in triplicate with the Kansas Corporation Commission, 200 Colorado Derby Building, Wichita, Kansas 67202, within ten days after the completion of the well, regardless of how the well was completed. Circle one: Oil, gas, dry, SWD, OWWO, injection. Type and complete ALL sections. Applications must be filed for dual completion, commingling, salt water disposal and injection. Attach wireline logs (i.e. electrical log, sonic log, gamma ray neutron log, etc.) KCC#-(316)263-3238.

OPERATOR Jennings Drilling Co.API NO. 15-103-20144ADDRESS 646 LouisianaCOUNTY LeavenworthLawrence, Kansas 66044FIELD Linwood**CONTACT PERSON John P. JenningsPROD. FORMATION DryPHONE (913) 749 1581LEASE Burke

PURCHASER _____

WELL NO. # 1

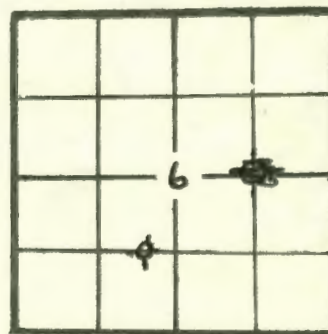
ADDRESS _____

WELL LOCATION C E/2 E/2 SW/4 6-12S-22EDRILLING H & H Drilling Co.

CONTRACTOR _____

ADDRESS Paola, Kansas330 Ft. from East Line and1,320 Ft. from North Line ofthe SW/4 SEC. 6 TWP. 12 RGE. 22EPLUGGING Brewer Inc.

CONTRACTOR _____

ADDRESS Dasehor, Kansas

WELL PLAT

KCC

KGS

MISC

(Office Use)

TOTAL DEPTH 790' PBTD _____SPUD DATE 10/21/81 DATE COMPLETED 10/23/81ELEV: GR 947 DF _____ KB _____DRILLED WITH (~~rotary~~) (ROTARY) (~~tools~~) TOOLS (~~used~~) / (Used) casing.

CASING RECORD

Report of all strings set — surface, intermediate, production, etc.

Purpose of string	Size hole drilled	Size casing set (in O.D.)	Weight lbs/ft.	Setting depth	Type cement	Sacks	Type and percent additives
Surface	10"	7"	141b	120'	Common	60	posmixx

LINER RECORD

PERFORATION RECORD

Top, ft.	Bottom, ft.	Sacks cement	Shots per ft.	Size & type	Depth interval

TUBING RECORD

Size	Setting depth	Packer set at			

529523

Estimated height of cement behind Surface Pipe To the top.DV USED? no

6-125-22E

~~6-18-22~~

WELL LOG

Formation Description, Contents, etc.	Top	Bottom	Name	Depth
Kansas City Line Stone	30 6'	414	Kansas City	306'
Shale	414	590	Cherokee	414
Line	590	594	Altamont	590
Shale	594	692	Cherokee	692
Sand	692	778	Squirrel	778

A F F I D A V I TSTATE OF Kansas, COUNTY OF Douglas SS, _____John P. Jennings OF LAWFUL AGE, BEING FIRST DULY SWORN UPON HIS OATH,DEPOSES THAT HE IS President (FOR)(OF) Jennings Drilling Co.OPERATOR OF THE Burke LEASE, AND IS DULY AUTHORIZED TO MAKETHIS AFFIDAVIT FOR AND ON THE BEHALF OF SAID OPERATOR, THAT WELL NO. 1 ON