


Section 34 Township 12 Range 22-E  
 Well No. #1 Doan  
 Company E. L. Cullum

NORTH Misc.

5

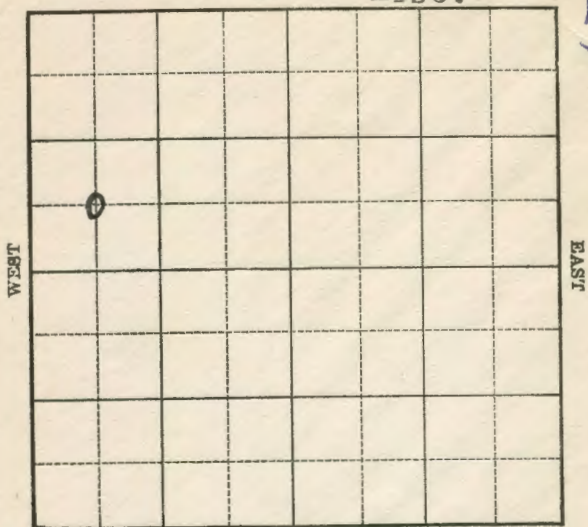


SOUTH

Sec. 34 Twp. 12 R. 22-E  
 Well No. #1 Doan Farm \_\_\_\_\_  
E. L. Cullum Company \_\_\_\_\_

(Miscellaneous)

\_\_\_\_\_ Ft. from N. Line  
660 Ft. from S. Line  
 \_\_\_\_\_ Ft. from E. Line  
660 Ft. from W. Line

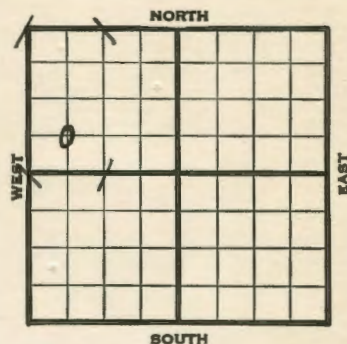

1939	913	REPORT
11/22		Machine 35'
11/29		Spud 35' SD.
12/7		10" - 580' SD.
12/14		Drlg. 730'
12/21		835' U.R. 8".
12/28		Burbank 800' 8" - 853'
		Fsg. bailer.
1940		
1/4	" "	
1/11	" "	
1/18		SD 940'
1/25	" "	
2/1	" "	
2/8	" "	
2/15	" "	
2/23	" "	
2/29		SD 1000'
3/8	" "	
3/14	" "	
3/21	" "	
3/28	" "	
4/4		Drlg. 1240' <b>OVER</b>

529613

940  
/12 Miss. L. 987'  
SD 1342'

/18 Base Miss. 1387'  
Drlg. 1410'

/25 TD 1433' Run 6".

/2 " " "

/9 " " "

/16 Shut down.

/23 " "

/29 SD 1500'

/6 " "

/13 SD 1535'

/20 " "

/27 " "

/3 " "

/11 " "

/18 " "

/25 " "

/2 " "

/8 " "

8/14 " "

3/22 " "

3/29 " "

0/5 " "

9/12 " "

/18 Hunton 1449'  
T.D. ~~XXXX~~ 1585'

1449  
987  
462

ABANDONED

Map No. NM Sec. 34 Twp. 12 R. 22E

Well No. 1 Doan

E. L. Cullum Company

Contractor

**FIRST REPORT**

**SECTION PLAT**

C SW NW

Ft. from N. Line

660 Ft. from S. Line

Ft. from E. Line

660 Ft. from W. Line


**MISCELLANEOUS**

Location \_\_\_\_\_

Rig up \_\_\_\_\_

Drilling and Remarks:

Machine 35'

**RECORD**

Cased \_\_\_\_\_ in., \_\_\_\_\_ ft.

Sand \_\_\_\_\_

Gas \_\_\_\_\_

Oil \_\_\_\_\_

Total Depth \_\_\_\_\_

**PRODUCTION**

1st 24 hrs. Nat. \_\_\_\_\_

1st 24 hrs. after shot \_\_\_\_\_

Gas \_\_\_\_\_ Cu. Ft.

Dry Hole \_\_\_\_\_

Abandoned \_\_\_\_\_

Date

NOV 22 1939 19

S. J. LEWIS Scout

Map No. NM Sec. 34 Twp. 12 R. 22 E

Well No. 1 Doan

E. L. Cullum Company

Contractor

**ABANDONED**

**SECTION PLAT**

C SW NW

Ft. from N. Line

660 Ft. from S. Line

Ft. from E. Line

660 Ft. from W. Line


**MISCELLANEOUS**

Location \_\_\_\_\_

Rig up \_\_\_\_\_

Drilling and Remarks:

Hunter 1449

**RECORD**

Cased \_\_\_\_\_ in., \_\_\_\_\_ ft.

Sand \_\_\_\_\_

Gas \_\_\_\_\_

Oil \_\_\_\_\_

Total Depth 1585

**PRODUCTION**

1st 24 hrs. Nat. \_\_\_\_\_

1st 24 hrs. after shot \_\_\_\_\_

Gas \_\_\_\_\_ Cu. Ft.

Dry Hole \_\_\_\_\_

Abandoned \_\_\_\_\_

Date

SEP 18 1940 19

S. J. LEWIS Scout