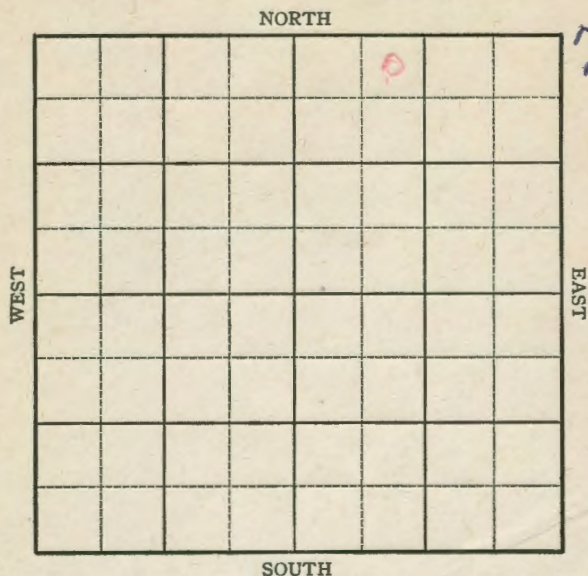


KANSAS

Leavenworth

Section 11 Township 12 Range 22EWell No. 1 HoffineCompany Workman et al


KANSAS

Leavenworth

Sec. 11 Twp. 22 / 2 R. 22-EWell No. #1 Hoffine FarmWorkman et al Company330 Ft. from N. Line

Ft. from S. Line

Ft. from E. Line

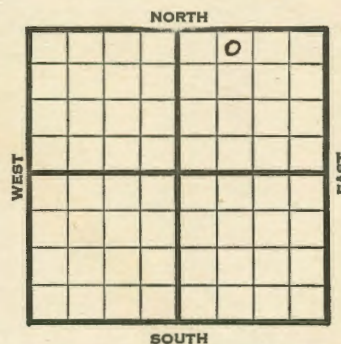990 Ft. from W. Line

NE NW NE

1945

Elev. 1959

REPORT

8/1

10" @ 52'

8" @ 943'

Miss 1045

Hunton 1473

6" @ 1473'

T.D. 1550'

D&A

FIRST REPORT
 +
ABANDONED

1473
 1045
 428

Kansas Pool Name McLouth
 Map No. 2 Sec. 11 Twp. 12 R. 22E
 Well No. 1 Hoffine

Workman et al. Company
CORRECTION Contractor

NE NW NE

SECTION PLAT

330 Ft. from N. Line

Ft. from S. Line

Ft. from E. Line

990 Ft. from W. Line

Leavenworth County

RECORD

Location _____
 Rig up _____
 Drilling and Remarks:
 reported 11-22-23E
 Cased _____ in. _____ ft.
 Sand _____
 Gas _____
 Oil _____
 Total Depth _____

PRODUCTION

1st 24 hrs. Nat. _____
 1st 24 hrs. after shot _____
 Gas _____ Cu. Ft.
 Dry Hole _____
 Abandoned _____

Date

AUG 1 1945 19 S. J. LEWIS Scout

Kansas Pool Name McLouth
 Map No. 2 Sec. 11 Twp. 22 R. 22E
 Well No. 1 Hoffine

Workman et al. Company
FIRST REPORT
ABANDONED Contractor
 E 1949

NE NW NE

SECTION PLAT

330 Ft. from N. Line

Ft. from S. Line

Ft. from E. Line

990 Ft. from W. Line

Leavenworth

RECORD

Location _____
 Rig up _____
 Drilling and Remarks:
 10"-52'
 8"-943'
 Miss- 1045
 Hunton 1473
 6"-1473
 D & A
 Cased _____ in. _____ ft.
 Sand _____
 Gas _____
 Oil _____
 Total Depth 1530

PRODUCTION

1st 24 hrs. Nat. _____
 1st 24 hrs. after shot _____
 Gas _____ Cu. Ft.
 Dry Hole _____
 Abandoned _____

Date

AUG 1 1945 19 S. J. LEWIS Scout