

E W

25

S

12

23

Range

Township


Section

JOHNSON
County
VAUGHN
Farm

No.

75th Sunset
Company
Kansan City Mo

Sec.

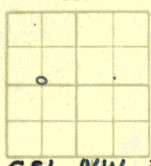

Twp.

6	5	4	3	2	1
7	8	9	10	11	12
13	17	16	15	14	13
19	20	21	22	X	24
30	29	28	27	26	25
31	32	33	34	35	36

CSL NW ?


Elev. _____ T.D. 295

Date Drilled 5-6-36

Correlation by _____

PR 0

Soil + clay yellow soft 1/2

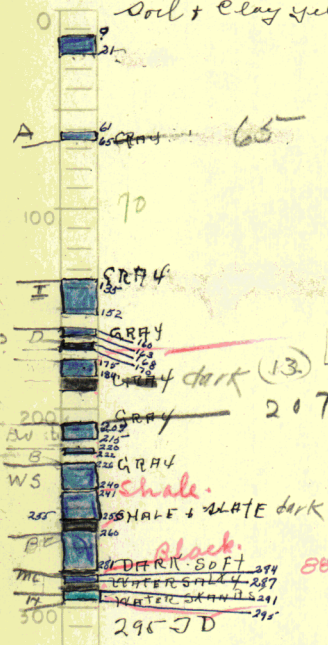

142

8

207

88