

GEOLOGICAL DEPARTMENT
SOUTHWESTERN GAS COMPANY
INDEPENDENCE, KANSAS

Company Lockwood and Lambrie

S. T. R. 24-12-23
County Johnson
State Kansas
Lease and Well No. Fairfield Investment Co. #1

Contractor Ben Endicott

Drilling Commenced 1923


Drilling Completed

Initial Production Dry

Initial Rock Pressure

Location Center of W. line of SE $\frac{1}{4}$ of SW $\frac{1}{4}$

Casing

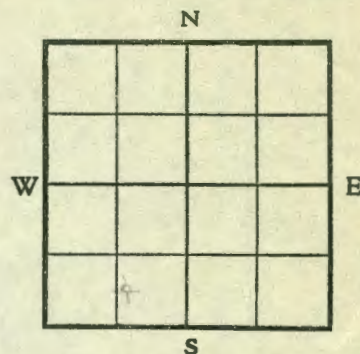

Driller's Record of Formations

surface	20	20	shale grey	105	570
shale blue	25	45	lime	4	574
lime	20	65	shale light	76	650
shale green	5	70			
lime brown	10	80			
shale black	5	85			
lime	10	95			
shale dark	15	110			
lime	7	117			
shale dark	3	120 water			
lime	30	150			
slate water	4	154			
lime white	24	178			
slate water	2	180			
lime white	20	200			
shale light	5	205			
red rock	2	207			
sand	8	215			
shale	108	320			
red rock	4	324			
shale grey	4	328			
red rock	10	338			
shale green	10	348			
lime	2	350			
shale	15	365			
lime	7	372			
red rock	4	376			
lime	6	382			
shale dark	20	410			
slate gas	4	414			
lime and sand	11	425			
shale	1	426			
sand	6	434			
lime	6	440			
shale white	2	442			
red rock	2	450			
shale black	10	460			
lime	4	464			
shale blue	5	469			
shale white	10	470			