

GEOLOGICAL DEPARTMENT  
UNION GAS CORPORATION  
INDEPENDENCE, KANSAS

Company **Union Gas Corporation**

S. T. R. 17-12-26  
County Johnson  
State Kansas  
Lease and Well No. **Mary C. Renner #1**

Contractor **Archie Newland**


Drilling Commenced **Dec. 8, 1926**      Drilling Completed **Dec. 16, 1926**

Initial Production **200,000 cu. ft. gas**      Initial Rock Pressure

Location **600' E. and 210' N. of SW corner of Section**

Casing **8" 19'**  
**2" tubing 448'**  
**packer set at 399'**

*SW SW SW W*

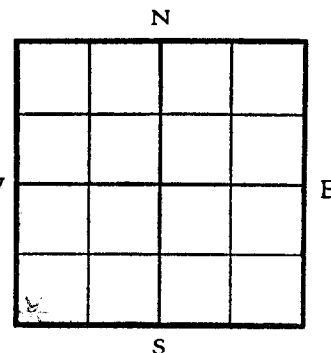

Driller's Record of Formations

5	soil	5	5	shale dark	360
15	mud yellow	20	2	lime shells white	362
9	shale blue	29	9	shale light	371
7	lime white	36	3	lime	374
3	shale blue	39	5	sand dark	379
5	lime white hard	44	19	shale dark	390
4	shale dark	48	3	lime	401
2	lime white	50	2	slate black	403 S.L.M.
8	shale blue muddy	58	14	sand carrying	
9	granite blue	67		200,000 gas	417
5	asphalt black	72	10	shale light	427
13	lime white hard	85	23	shale dark	450
19	shale blue	104		S.L.M.	
3	lime white	107		T.D.	450
5	shale blue muddy	112			
11	lime sharp	123			
2	shale dark	125			
15	lime white	140			
7	shale dark	147			
20	lime	167			
	some water and gas				
	under lime				
3	shale blue	170		some gas	
2	lime light	172			
5	shale light	177			
8	lime white	185			
9	shale light	194			
6	sand little gas	200			
10	shale dark	210			
26	shale light	236			
50	shale blue	236			
6	shale white	292			
9	sand little gas	301		S.L.M.	
9	shale	310			
6	red bed	316			
24	shale dark muddy	340			
9	shale light	349			
6	slime	355			

GEOLOGICAL FORM 9