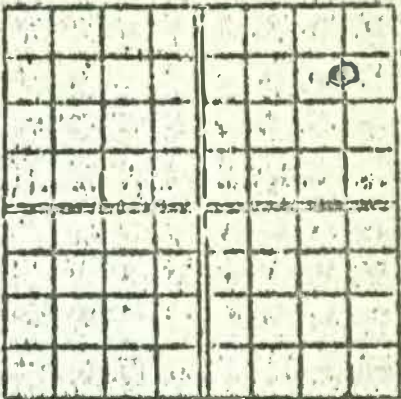


MISSOURI GEOLOGICAL SURVEY AND WATER RESOURCES
 ROLLA, MISSOURI

17-12-24E
ORIGINAL

COUNTY Johnson - Kans
 COMPANY OR OWNER F E Young
 FARM est WELL NO. _____
 LOCATION SEC. 14 T. 12S R. 24E
 CONTRACTOR _____
 DRILLER Lee T. ... TOOL DR. _____
 CASING _____ COMPLETED _____
 PRODUCTION _____ PLOTTED _____
 CASING RECORD _____
 WATER RECORD _____
 SOURCE OF LOG Reuther - memory
 NUMBER 10428 - W-6-428

LOG NUMBER _____

 ELEV. CS/2 NE NE
 TOTAL DEPTH _____

FORMATION	THICK.	DEPTH	FORMATION	THICK.	DEPTH
-----------	--------	-------	-----------	--------	-------

Sand & clay	0	40			
Clay	40	46	little water		
Shale & sand	46	50			
lime	50	90	little water		
gray shale	90	115			
lime	115	125			
shale & sand	125	132	3/27/15		

Bailed 90 gal. after starting pump

made top card