

**GEOLOGICAL DEPARTMENT
UNION GAS CORPORATION
INDEPENDENCE, KANSAS**

Company **J. V. Huffman, et al.**

S. T. R. **16-12-24**
County **Johnson**
State **Kansas**
Lease and Well No. **Scott #2**

Contractor

Drilling Commenced

Drilling Completed


7/16/25

Initial Production **Gas**

Initial Rock Pressure

Location **NE corner of SE $\frac{1}{4}$ of SE $\frac{1}{4}$**

Casing Drive pipe 20'
3" cage at 574'
Bottom of packer rubber 518'

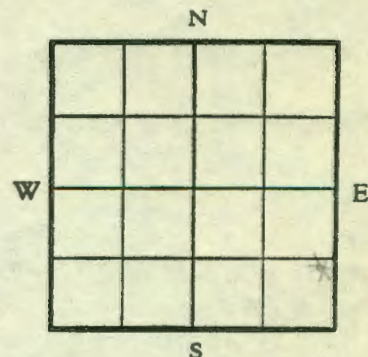

Driller's Record of Formations

surface	12	12	dark shale	3	398
gravel	6	18	light shale	27	425
lime	12	30	dark shale	14	439
blue shale	43	73	lime	5	444
lime	8	81	sand and gas	12	456
blue shale	3	84	white shale	7	463
lime	2	85 ?	lime	4	467
blue shale	11	96	red rock	5	472
lime	9	105	blue shale	6	478
dark shale	5	110	black slate	5	483
lime	15	125	dark shale	39	564
blue shale	31	156	sand and gas	18	582
lime	16	172	white shale	42	525
light shale	3	175			
lime	8	183			
black slate	5	188			
blue shale	3	191			
lime	18	209			
black slate	4	213			
lime	2	215			
dark shale	3	218			
lime	9	227			
white shale	5	232			
red rock	3	235			
white shale	5	240			
sand	5	245			
dark shale	5	250			
sand gas	15	265			
blue shale	45	310			
white shale	38	348			
black slate	3	351			
red rock	10	361			
white shale	4	365			
red rock	6	371			
light shale	20	391			
lime	4	395			

Geological Form 5

LISTED BY HET PETI TETEVSONY

18-12-24E *Plotted I.R.*
R. 24 *0*

Company

Sec. 18 T. 12 R. 24
Loc. NE ~~cor~~ SE $\frac{1}{4}$ SE $\frac{1}{4}$

Farm Scott Well

No. 2

County Johnson

Total Depth 582'


Comm.

Comp.

Shot or Treated

Contractor Earl Smith

Issued

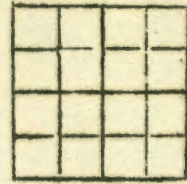

Casing

20 in.	10 in.
15 1-2	8 1-4
12 1-2	6 5-8
13 3-8	5 3-16

Elevation

Production

Figures Indicate Bottom of Formation

Surface	12'	Light shale	425
Gravel	18	Dark shale	439
Lime	30	Lime	444
Blue shale	73	Sand & gas	456
Lime	80	White shale	463
Blue shale	85	Lime	467
Lime	85	Red rock	472
Blue shale	96	Blue shale	478
Lime	105	Black slate	483
Dark shale	110	White shale	525
Lime	125	Dark shale	564
Blue shale	156	Sand & gas	582
Lime	172		
Light shale	175	2" Cage at 574	
Lime	183	Bottom of Packer Rubber 518'	
Black slate	188		
Blue shale	191		
Lime	209		
Black skate	213		
Lime	215		
Dark shale	218		
Lime	227		
White shale	232		
Red rock	235		
White shale	240		
Sand	245		
Dark shale	250		
Sand & gas	265		
Blue shale	310		
White shale	348		
Black slate	351		
Red rock	361		
White shale	365		
Red rock	371		
Light shale	391		
Lime	395		
Dark shale	398		