


MISSOURI GEOLOGICAL SURVEY AND WATER RESOURCES
ROLLA, MISSOURI

WVZ
 COUNTY Johnson
 COMPANY OR OWNER Berkshire
 FARM NO WELL NO. _____
 LOCATION _____ SEC. 33 T. 12S R. 25E
 CONTRACTOR William & Brown Drilling Co
 DRILLER R. L. Korman TOOL DR. Int. Transwell
 COMMENCED 8/10/50 COMPLETED 8/18/50
 PRODUCTION 206 PIT PLOTTED _____
 CASING RECORD _____
 WATER RECORD _____
 SOURCE OF LOG Well as original
 REMARKS _____

LOG NUMBER _____

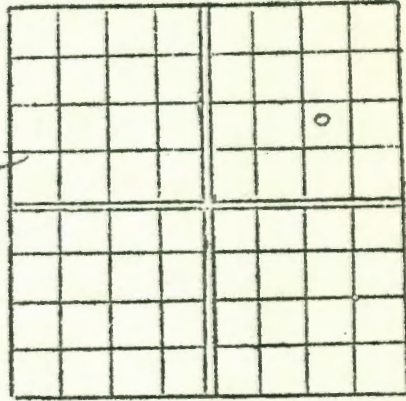

ELEV. 980±
 TOTAL DEPTH _____

FORMATION	THICK.	DEPTH	FORMATION	THICK.	DEPTH
Spill clay		32			
Boulders	3	32	water soft in 8" hole in 120 hrs		
Lime shale	12	35			
Shale	4	47	Raytown		
Shale	3	51			
Shale	6	54			
Lime green shale	4	60			
(CL)	10	64	Cement City		
Shale green	2	74			
Shale dark gray	3	76			
Lime Drum	32	79			
Shale	16	111			
Lime (WS)	30	127			
Shale gray	4	157			
Shale slate black	3	161			
Lime BF	16	164	water to 100' level		

980
 164
 816

980
 127
 853