


Map No. **KANSAS** Sec. 3 Twp. 12 R. 3 E
 Well No. 1- Huffer Farm
Empire O. & R. Company

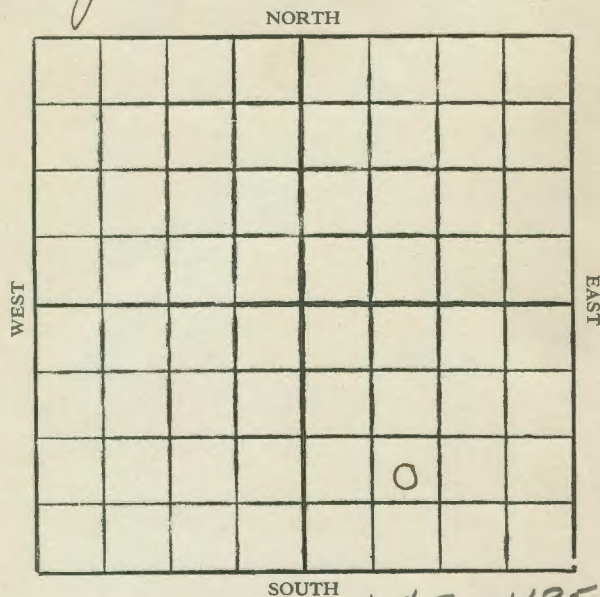

15
L85 1195 Grd.

Location _____ Rig Up _____
 Drilling Remarks _____ Drilling Remarks _____

RECORD

Cased _____ in. _____ ft.
 Sand _____
 Gas _____
 Oil _____
 Total Depth _____

PRODUCTION

1st 24 hrs. Nat. _____
 1st 24 hrs. after shot _____
 Gas _____ cu. ft.
 Dry Hole _____
 Abandoned _____


Map No. **KANSAS** Sec. 3 Twp. 12 R. 3 E
 Well No. 1- Huffer Farm
Empire O. & R. Company

_____ Ft. from N. Line

990 Ft. from S. Line

_____ Ft. from E. Line

990 Ft. from W. Line

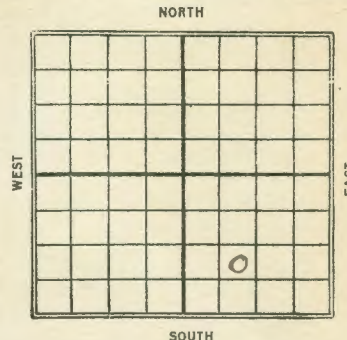

1928

Date

REPORT

5/23 Location

5/31 Rig

6/6 Rig




































































































































MAP No. 11993 SEC. 3 TWP. 12 R. 3EWELL No. 1 TuffeyEmpire Oil & Ref. COMPANY

CONTRACTOR

SECTION PLAT

Ft. FROM N. LINE

990 Ft. FROM S. LINE

Ft. FROM E. LINE

990 Ft. FROM W. LINE

ABANDONED

LOCATION

RIG UP

DRILLING AND REMARKS:

Top Oil & 2953AFWTD 2980DA

RECORD

CASED _____ IN. _____ FT.

SAND _____

GAS _____

OIL _____

TOTAL DEPTH _____

PRODUCTION

1ST 24 HRS. NAT. _____

1ST 24 HRS. AFTER SHOT _____

GAS _____ Cu. Ft.

DRY HOLE _____

ABANDONED _____

DATE

SEP 19 1928 192 S. J. LEWIS SCOUTMAP No. 11993 SEC. 3 TWP. 12 R. 3EWELL No. 1 TuffeyEmpire Oil & Ref. COMPANY

CONTRACTOR

SECTION PLAT

Ft. from N. Line

990 Ft. from S. Line

Ft. from E. Line

990 Ft. from W. Line

FIRST REPORTS

Location ✓

Rig up _____

Drilling and Remarks:

RECORD

Cased _____ in. _____ ft.

Sand _____

Gas _____

Oil _____

Total Depth _____

PRODUCTION

1st 24 hrs. Nat. _____

1st 24 hrs. after shot _____

Gas _____ Cu. Ft.

Dry Hole _____

Abandoned _____

Date

MAY 23 1928 192 S. J. LEWIS Scout