


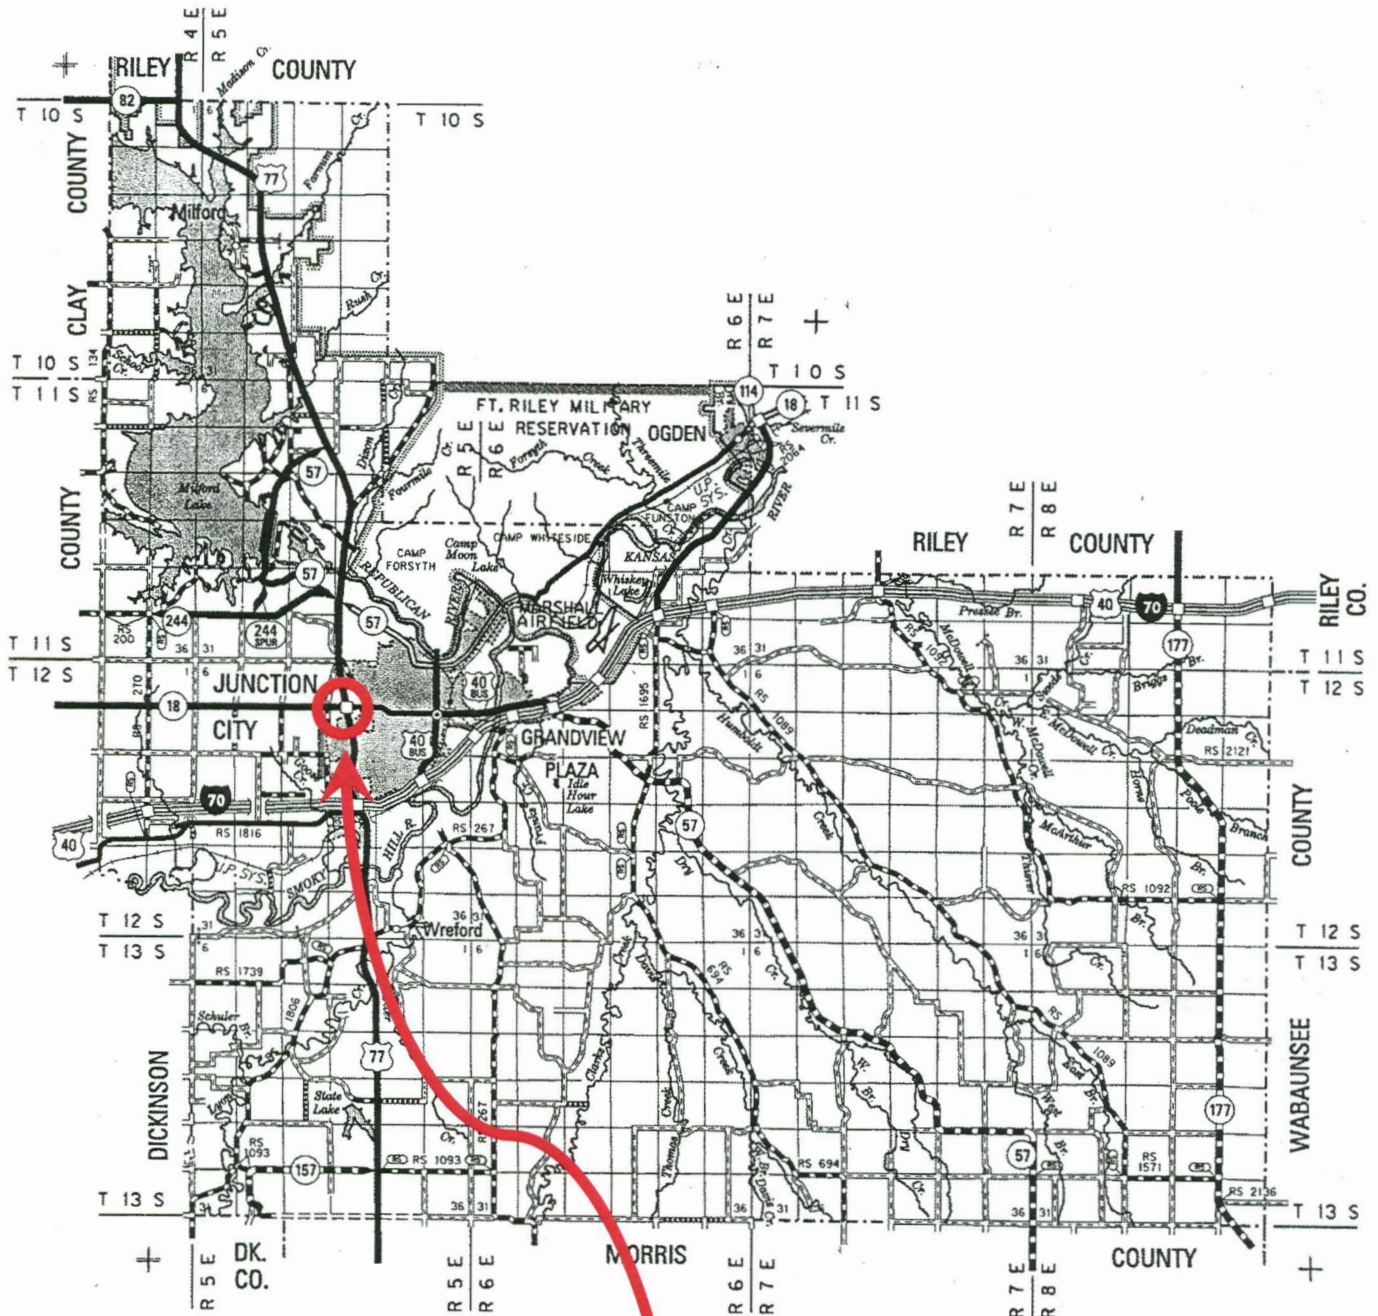

How: CH-3

STA: 49+69, 40' RT

1-14-2015

Br. NO. 77-31-11.23 (088)

3 Boxes

Box 1: 22.5 - 36

Box 2: 36 - 48.2

Box 3: 48.2 - 55.5

Bridge Foundation Report
Project 77-31 KA-2367-04
K-18 over US-77
Br. 18-31-5.26 (088)
Geary County

4 boxes

CH-1

STA: 51+31 38FT RT &
3.5-19.6

01-12-2015

39.080067, -96.865474
178 SF 2