



Section 7 Township 12 Range 8E
Well No. #1 Grover Poole
Company Eagle Drlg.

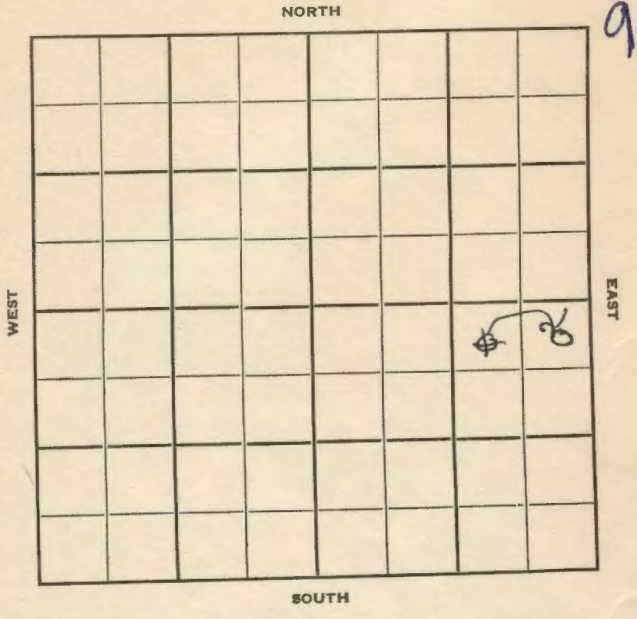

Sec. 7 Twp. 12- R. 8E
Well No. #1 Grover Poole Farm
Eagle Drlg. Company
Contractor

500
330 Ft. from N. Line
Ft. from S. Line
330
990 Ft. from E. Line
Ft. from W. Line
~~NW NE SE~~
NENE SE

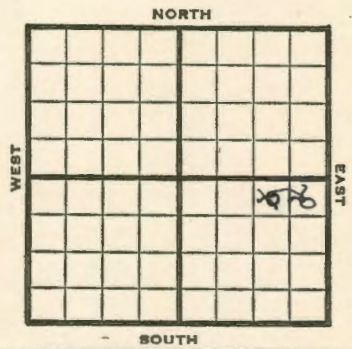

1952 Elev. 1259' REPORT

10/1 Spud 9-29-52
8" @ 76
10/15 Spud 9-29-52
D&A TD 2167' 8" @ 76
Lans. 1295 Cong. 1753
Miss. 1768 Hunton 2101
TD 2167 D&A

ABANDONED

2101
1768

333

County Geary State Kansas
 Sec. 7 (Blk. Twp.) 12 (Sur. Rge.) 8E Map No.
 Operator Eagle Drig.
 Well No. 1 Farm Grover Poole
 Lev. NW NE SE Location

330 Ft. From N Line SE
990 Ft. From E Line Quarter
 1st. Report OCT 1 1952
 Completion _____
 Remarks _____
 Spudding Date 9-29-52

FIRST REPORT

Rig. Data Wildcat

8" @ 70

11

J. G. McGEHEE

Map No. _____ Sec. 7 Twp. 12 R. 8E

Well No. 1 Grover Poole
Eagle Drig. Company
CORRECTION Contractor

NE NE SE

SECTION PLAT

500 Ft. from N. Line
 _____ Ft. from S. Line
330 Ft. from E. Line
 _____ Ft. from W. Line

Geary County

Location _____
 Rig up _____
 Drilling and Remarks:

Reported
 NW NE SE

RECORD

Cased _____ in., _____ ft.
 Sand _____
 Gas _____
 Oil _____
 Total Depth _____

PRODUCTION

1st 24 hrs. Nat. _____
 1st 24 hrs. after shot _____
 Gas _____ Cu. Ft.
 Dry Hole _____
 Abandoned _____

Date

OCT 8 1952

J. G. McGEHEE

Scout

