


Geary

15-061-00031

Section 10 Township 12 Range 8E

Well No. #1 Aye

Company Fowler & Tighe et al

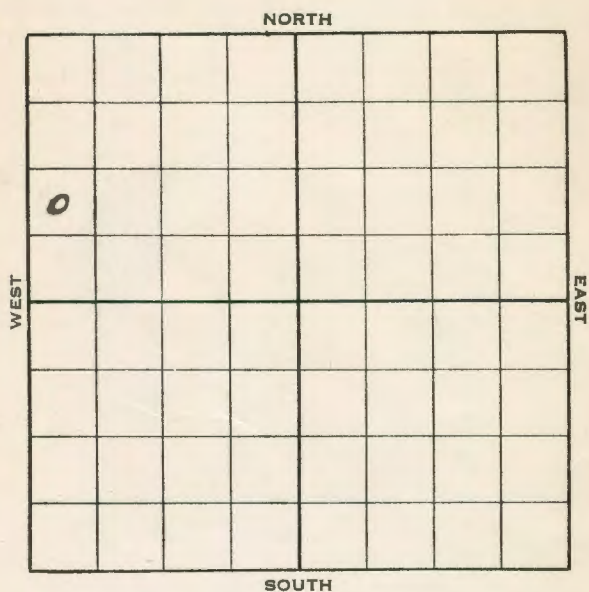

Sec. 10 Twp. 12 R. 8-E


Well No. #1 Aye Farm  
Fowler & Tighe et al Company

Ft. from N. Line

990 Ft. from S. Line

Ft. from E. Line

330 Ft. from W. Line

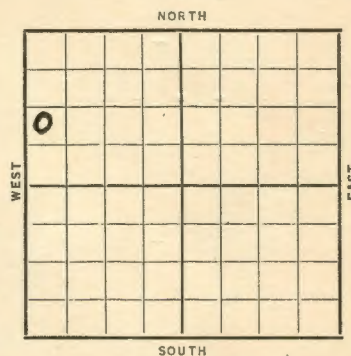

| Date  | REPORT     |                   |
|-------|------------|-------------------|
| 1938  |            |                   |
| 8/3   | Spud.      | 12/23 SD 440'.    |
| 8/12  | Shut down. | 12/30 "           |
| 8/19  | " "        | 1939              |
| 8/26  | Dlg. 110'. | 1/6 "             |
| 9/2   | Dlg. 145'. | 1/13 "            |
| 9/9   | " "        | 1/20 "            |
| 9/16  | SD 300'.   | 1/27 Drlg. 445'.  |
| 9/23  | " "        | 2/3 SD 488' rprs. |
| 9/30  | " "        | 2/10 " "          |
| 10/7  | SD 440'.   | 2/17 " "          |
| 10/14 | " "        | 2/23 " "          |
| 10/21 | " "        | 3/3 " "           |
| 10/28 | " "        | 3/10 Drlg. 605'   |
| 11/4  | " "        | 3/16 Shut down.   |
| 11/12 | " "        | 3/24 " "          |
| 11/18 | " "        |                   |
| 11/25 | " "        |                   |
| 12/2  | " "        | OVER              |
| 12/9  | " "        |                   |
| 12/15 | " "        |                   |
|       |            |                   |
|       |            |                   |

939  
 /31 T.D. 892' Rng. 10".  
 /7 10" - 892' Drlg. 1235'  
 /14 S.D. 1235'  
 /21 " "  
 /28 " "  
 /5 10" - 900' Drlg. 1655'  
 /12 8" - 1710' SD.  
 /19 8" - 1755' C. O.  
 /26 " " "  
 /1 Gas at 1600'  
 T.D. 1857' SD.  
 /8 1857 S.D.  
 /16 Drlg. 1902'  
 /23 Caving hole 1909' C. O.  
 /29 6" - 1933' T.D. 1938'  
 U.R. 6".  
 /6 Shut down.  
 /13 Miss. 1900' 6" - 1938'  
 Drlg. 1965'  
 /20 6" - 1966' T.D. 2050' U.R. 6".  
 /27 6" - 2050' T.D. 2107' SD.  
 /3 Hunton 2125' 6" - 2150'  
 T.D. 2225' U.R. 6".  
 /9 T.D. 2239'  
 H.F.W.

**ABANDONED**

Geary

KANSAS

Map No. 100 Sec. 10 Twp. 12 R. 8EWell No. 1 Aye

Fowler &amp; Tighe etal Company

Contractor

ABANDONED

NW SW NW

Ft. from N. Line

990 Ft. from S. Line

Ft. from E. Line

330 Ft. from W. Line

WILDCAT

## SECTION PLAT

|   |  |  |  |
|---|--|--|--|
|   |  |  |  |
| 0 |  |  |  |
|   |  |  |  |
|   |  |  |  |

Location

## RECORD

Cased in. ft.

Sand

Gas

Oil

Total Depth 2289

## PRODUCTION

1st 24 hrs. Nat.

1st 24 hrs. after shot

Gas Cu. Ft.

Dry Hole

Abandoned

Date

AUG 9 1939

19

S. J. LEWIS

Scout

Geary

KANSAS

Map No. 100 Sec. 10 Twp. 12 R. 8EWell No. 1 Aye

Fowler &amp; Tighe etal Company

Contractor

FIRST REPORT

NW SW NW

Ft. from N. Line

990 Ft. from S. Line

Ft. from E. Line

330 Ft. from W. Line

## SECTION PLAT

|   |  |  |  |
|---|--|--|--|
|   |  |  |  |
| 0 |  |  |  |
|   |  |  |  |
|   |  |  |  |

Location

## RECORD

Cased in. ft.

Sand

Gas

Oil

Total Depth

## PRODUCTION

1st 24 hrs. Nat.

1st 24 hrs. after shot

Gas Cu. Ft.

Dry Hole

Abandoned

Date

AUG 3 - 1938

19

H. D. Hatfield Scout