

LAUGHLIN-SIMMONS & CO. OF KANSAS, INC.
 OILWELL ELEVATIONS AND LOCATIONS
 2121 W. 18TH STREET (316) WH 3-5351
 WICHITA, KANSAS 67203

1-11-74

DATE


Wabaunsee 27 12s 9e SE NE SW
 COUNTY S T R LOCATION

Glen Rupe 1 Meseke
 OPERATOR NO. FARM

ELEVATION: 1284 62
 (ATTN 9' KB)

Mr. Glen N. Rupe
 925 Olive Garvey Building
 Wichita, Kansas 67202

SCALE: 2" = 1 Mile

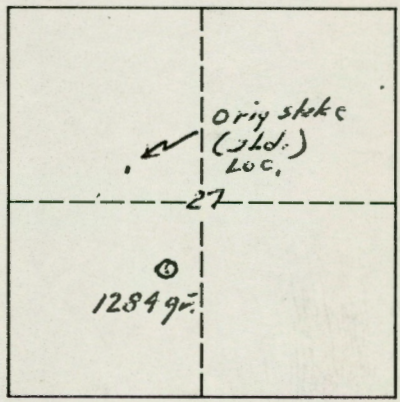

REC'D JAN 12 1974

MINIMUM STAKING CHARGE: ~~460.00~~
 EXTRA TIME & MILEAGE: ^{40 = 4} \$10.00 (No other work in area)
 ELEVATION CHARGE: \$40.00 (minimum chg)
 TOTAL: \$50.00

Thank you,
 R. E. Dose
 L-S ENGINEER

Laughlin-Simmons & Co. of Kansas, Inc. is not liable in case of errors and/or omissions.