


Give All Information Completely
Make Required Affidavit
Mail or Deliver Report to:
Conservation Division
State Corporation Commission
212 No. Market
Wichita, Kansas 67202

WELL PLUGGING RECORD

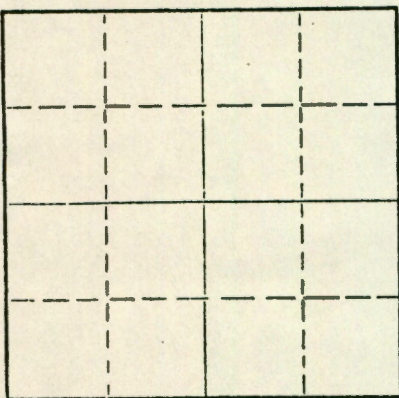

Locate well correctly on above
Section Plat

Wabaunsee County, Sec. 27 Twp. 12S Rge. 9 (E) E (W)

Location as "NE/CNW/SW" or footage from lines _____
Lease Owner G. N. Rupe
Lease Name Meseke Well No. 1
Office Address 925 O. W. Garvey Bldg., 200 W. Douglas, Wichita, Kansas 67202
Character of Well (completed as Oil, Gas or Dry Hole) Dry
Date well completed January 13, 1974
Application for plugging filed January 13, 1974
Application for plugging approved January 13, 1974
Plugging commenced 1-13-74 _____ 19____
Plugging completed 1-13-74 _____ 19____
Reason for abandonment of well or producing formation dry

If a producing well is abandoned, date of last production _____ 19____
Was permission obtained from the Conservation Division or its agents before plugging was commenced? yes

Name of Conservation Agent who supervised plugging of this well Merl Hickey
Producing formation _____ Depth to top _____ Bottom _____ Total Depth of Well 2380 Feet
Show depth and thickness of all water, oil and gas formations.

OIL, GAS OR WATER RECORDS

CASING RECORD

FORMATION	CONTENT	FROM	TO	SIZE	PUT IN	PULLED OUT

Describe in detail the manner in which the well was plugged, indicating where the mud fluid was placed and the method or methods used in introducing it into the hole. If cement or other plugs were used, state the character of same and depth placed, from _____ feet to _____ feet for each plug set.

Set 306' of 7" casing and circ.. cement to surface.
Filled hole with mud to 200' set bridge at 200' put in 12 sxs. ~~XXXXX~~ cement, filled hole with mud to 30', set bridge at 30' put in 6 sxs. cement, cut surface off below ground level, no rat hole was drilled.

(If additional description is necessary, use BACK of this sheet)
Name of Plugging Contractor Alco Drilling Co., Inc.
Address 318 So. Jefferson, Iola, Kansas

STATE OF KANSAS, COUNTY OF ALLEN, ss.
L. W. McClain (employee of owner) or (owner or operator) of the above-described well, being first duly sworn on oath, says: That I have knowledge of the facts, statements, and matters herein contained and the log of the above-described well as filed and that the same are true and correct. So help me God.

(Signature) L W McClain
318 S Jefferson (Address)

SUBSCRIBED AND SWORN to before me this 11th day of February, 19 74

My commission expires August 2, 1974

Alene M. Gardner Notary Public.

State of Kansas



State Corporation Commission

CONSERVATION DIVISION

(Oil, Gas and Water)

P. O. Box 17027 3830 S. Meridian

WICHITA, KANSAS 67217

January 15, 1974

REC'D JAN 16 1974

WELL PLUGGING AUTHORITY


Well No.	1
Lease	James G. Meseke
Description	SE NE SW 27-12-9E
County	Wabaunsee
Total Depth	2380'
Plugging Contractor	Alco Drilling Company

G.N. Rupe
925 O.W. Garvey Bldg.
200 West Douglas
Wichita, Kansas 67202
Gentlemen:

This is your authority to plug the above subject well in accordance with the Rules and Regulations of the State Corporation Commission.

This authority is void after 90 days from the above date.

Yours very truly,

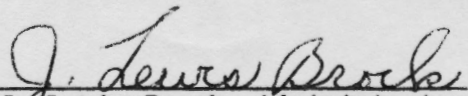
J. Lewis Brock, Administrator

Mr. Merle D. Hickey, Box 386, Lyndon, Kansas 66451
is hereby assigned to supervise the plugging of the above
named well.