

Dickinson KANSAS

Section 21 Township 13 Range 1 E

Well No. #1 Garvie

Company Jack Desbrow

Dickinson

Sec. 21 Twp. 13 R. KANSAS 1E

Well No. #1 Garvie Farm

Company Jack Desbrow

Contractor E. K. Carey-Contr.



1100' Ft. from N. Line

Ft. from S. Line

Ft. from E. Line

1320' Ft. from W. Line

C SL N 1/2 SW

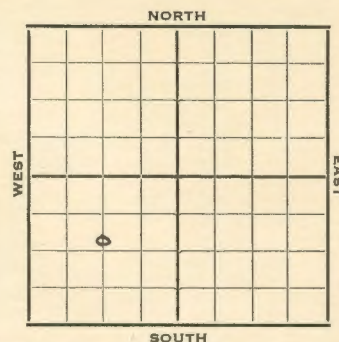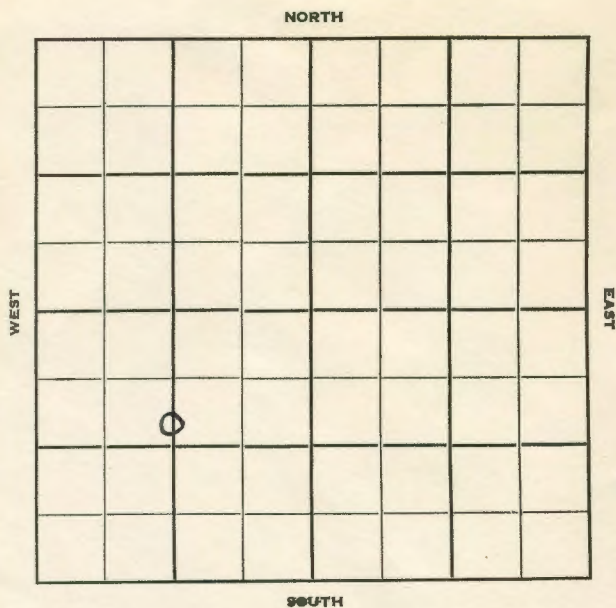

1952

Elev. 1163'

REPORT

3/12

MIM

4/30

Spud 3-16-52

D & A TD 3091' 8" @ 285 KC 1805'

Miss 2346' KC 2568' Hunton 2715'

Maq. sh. 2912'

TD 3015' 5" @ 3015 CO to 3013'

32/3000-3010 16/2346-51 S & B dry

scum oil. TD 3091' FU 500' water

Maq. dol. 3000' Viola 3009'

D & A

ABANDONED

County Dickinson State Kansas

Sec. 21 (Blk. Twp.) 13 (Sur. Rge.) 1E Map No.

Operator Jack Desbrow

Well No. 1 Farm Garvie

Elev. 1163 Location C S L N $\frac{1}{2}$ SW

1100Ft. From N Line SW

1320Ft. From W Line Quarter

1st. Report

Completion APR 30 1952

Remarks

E. K. Carey - Contr.

Spudding Date 3-16-52

Orig. Data D & A TD 3091

8" @ 285 KC 1805 Miss. 2346

KC 2568 Hunton 2715 Maq. sh. 2912

TD 3015 5" @ 3015 CO to 3013

32/ 3000-3010 16/ 2346-51 S & B dry

scum oil TD 3091 FU 500' water

Maq. dol. 3000 Viola 3009

D & A

2346
1163
1173

J. G. McGEHEE

