

Waubaussee

FORM 51


KANSAS

Section 13 Township B Range 10E

Well No. #1 Langley

Company Musgrove Pet. et al

NORTH

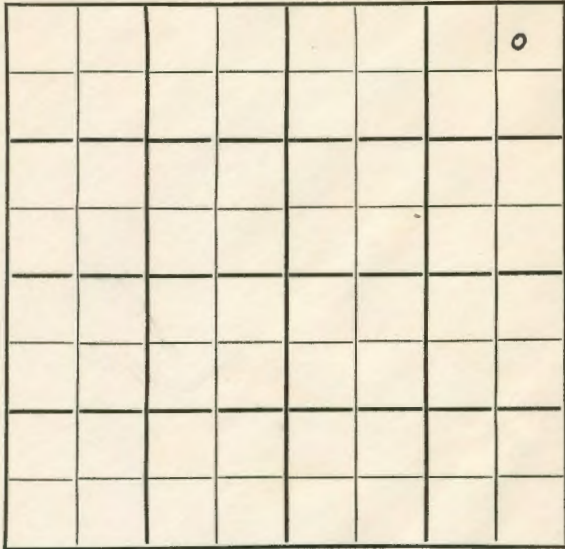

SOUTH

Waubaussee

KANSAS

SEC. 13 TWP. 13 R. 10E

WELL NO. #1 Langley

COMPANY Musgrove Pet. et al FARM

CONTRACTOR Musgrove Pet. et al


NORTH

330 Ft. from N. Line

\_\_\_\_\_ Ft. from S. Line

330 Ft. from E. Line

\_\_\_\_\_ Ft. from W. Line

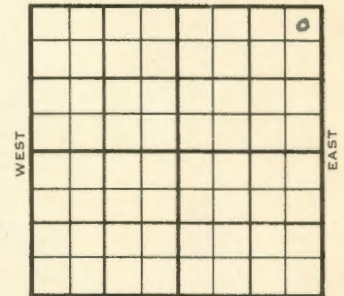

SOUTH

NE NE NE

Phillips DHM & AC.

ELEVATION

REPORT

1954 1201'

3/2 Location

4/21 Spud 3-4-54 D & A TD 3335  
 8" @ 127 Heeb 1112 Lans 1363  
 KC 1513 B KC 1728 Cherokee 1940  
 Miss 2395 Kh. 2706 Hunton 2895  
 Maq. 3051 Viola 3128 St. Peter 3251  
 Arb. 3312 TD 3335  
 B & A

ABANDONED

2395  
1201  
-1194

County Waubunsee State Kansas

Sec. 13 (Blk. Twp.) 13 (Sur. Rge.) 10E Map No.

Operator Musgrove Pet. etal.

Well No. 1 Farm Langley

Elev. 1201 Location NE NE NE

330 Ft. From N Line NE

330 Ft. From E Line Quarter

Ist. Report

Completion APR 21 1954

Remarks

Spudding Date 3-4-54

Drig. Data D & A TD 3335

8" @ 127 Heeb. 1112 Lans. 1363

KC 1513 B KC 1728 Cherokee 1940

Miss. 2395 Kh. 2706 Hunton 2895

Maq. 3051 Viola 3128 St. Peter 3251

Arb. 3312 TD 3335

D & A

J. G. MCGEHEE

County Waubunsee State Kansas

Sec. 13 (Blk. Twp.) 13 (Sur. Rge.) 10E Map No.

Operator Musgrove Pet. etal.

Well No. 1 Farm Langley

Elev. Location NE NE NE

330 Ft. From N Line NE

330 Ft. From N Line Quarter

Ist. Report MAR 3 1954

Completion

Remarks Phillips IHM & AC

Spudding Date

Drig. Data

Location

J. G. MCGEHEE

ABANDONED

FIRST REPORT