


Section 2 Township 13 Range 10EWell No. #1 PowellCompany Skelly Oil

NORTH

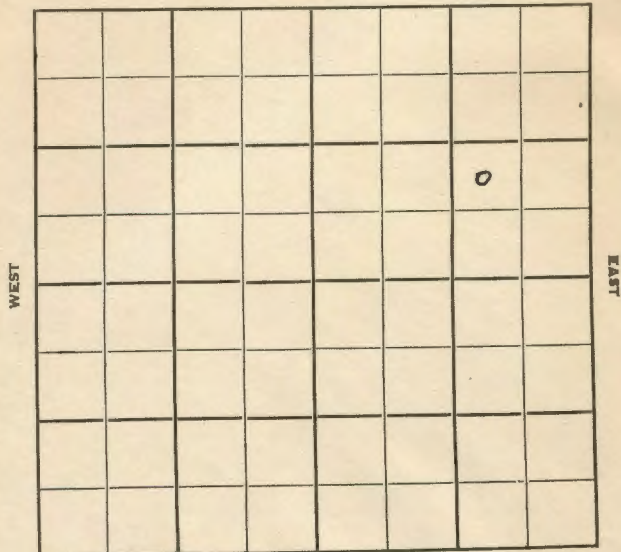

SOUTH

Sec. 2 Twp. 13 R. 10EWell No. #1 Powell FarmCompany Skelly OilContractor Adkins Drlg.

Mill Creek Pool

Ft. from N. Line


990' Ft. from S. Line

990' Ft. from E. Line

Ft. from W. Line

NW SE NE

NORTH

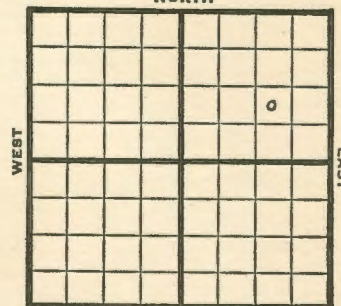

SOUTH

1950

Elev. 1102' REPORT

9/27

Spud 9-24-50

8" @ 204'

WOC

12/6

Spud 9-24-50

Oil Well TD 2941

8" @ 204' Top 666' Lans. 1234

KC 1379 BKC 1591

Miss 2196' Hunton 2684

Maq 2850 Viola 2936

DST 2936-4. opn 2 hr Rec. 350' oil

5" @ 2936' TD 2941

FU 1500' oil S/45 bo S/dry S/4 bo

2 hr S/2 boph P/91 bopd

Comp. 33 bopd 2% wtr.

COMPLETED

Top + 438

L - 132

BKC - 499

$$\begin{array}{r} 1102 \\ 666 \\ \hline 438 \end{array}$$

$$\begin{array}{r} 1591 \\ 1102 \\ \hline 489 \end{array}$$

$$\begin{array}{r} 1234 \\ 1102 \\ \hline 132 \end{array}$$

County Waubaussee State Kansas
 Sec. 2 (Blk.) 13 (Sur.) 10E Map No.

Operator Skelly Oil

Well No. 1 Farm Powell

Elev. 1102 Location NW SE NE

990 Ft. From S Line NE
 990 Ft. From E Line Quarter

1st. Report

Completion DEC 6 1950

Remarks Mill Creek Pool

Atkins Drlg. - Contr.

Spudding Date 9-24-50

Drlg. Data Oil well TD 2941

8" @ 204 Top. 666 Lans. 1234

KC 1379 B KC 1591 Miss. 2196

Punton 2684 Maq. 2850 Viola 2936

DST 2936-41 open 2 hr. Rec. 350' oil

5" @ 2936 TD 2941 FU 1500' oil

S/ 45 bo S/ dry S/ 4 bo 2 hr.

S/ 2 boph P/ 91 bopd

Comp. 33 bopd 2% water

J. E. TYRA

County Waubaussee State Kansas
 Sec. 2 (Blk.) 13 (Sur.) 10E Map No.

Operator Skelly Oil

Well No. 1 Farm Powell

Elev. Location NW SE NE

990 Ft. From S Line NE
 990 Ft. From E Line Quarter

1st. Report SEP 27 1950

Completion

Remarks

Adkins Drlg. - Contr.

Spudding Date 9-24-50

Drlg. Data

Mill Creek Pool

8" @ 204 WOC

J. E. TYRA