


Section 2 Township 13 Range 10EWell No. #3 ThoeweCompany Skelly Oil

NORTH

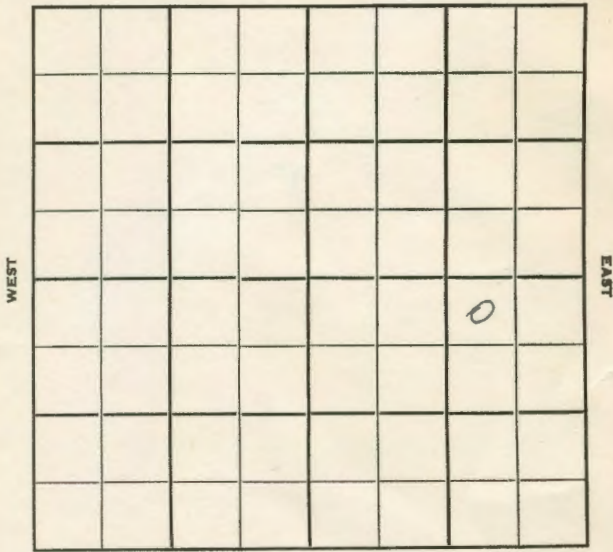

SOUTH


Sec. 2 Twp. 13 R. 10E ✓Well No. #3 Thoewe FarmSkelly Oil CompanyAtkins - Contr. ContractorMill Creek Pool330' Ft. from N. Line

Ft. from S. Line

990' Ft. from E. Line

Ft. from W. Line

NORTH

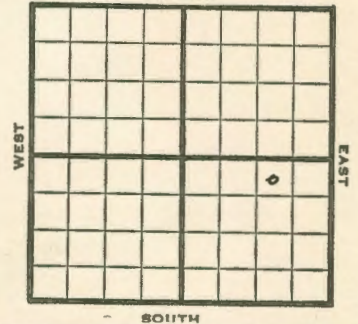

WEST

EAST

SOUTH

NW NE SE

1950

Elev. 1099' REPORT

12/6

Spud 12-1-50

8" @ 204

KC 1364'

Drlg. 1510'

1951

1/24

Spud 12-1-50

Oil Well TD 2921

8" @ 204' KC 1364'

Howard 560' Lans. 1223

BKC 1575' Miss 2205

B Miss 2471 Hunton 2667

Maq. 2839 Viola 2917

DST 2917-21 opn 1 hr Rec. 350' oil

10' ocm 5" @ 2917

TD 2921 S/45 bo 5 hr Comp. 121 bo

4 bwpd

COMPLETED

County Waubaussee State KansasSec. 2 (Blk. Twp.) 13 (Sur. Rge.) 10E Map No.Operator Skelly OilWell No. 3 Farm ThoeweElev. 1099 Location NW NE SE330 Ft. From N Line SE990 Ft. From E Line Quarter

1st. Report

Completion JAN 24 1951Remarks Mill Creek PoolAtkins - Contr.Spudding Date 12-1-50Orig. Data Oil Well TD 29218" @ 204 KC 1364 Howard 560 Lans. 1223B KC 1575 Miss. 2205 B Miss. 2471Hunton 2667 Maq. 2839 Viola 2917DST 2917-21 Opne 1 hr. Rec. 350' oil10' ocm 5" @ 2917 TD 2921 S/45 bo5 hr. Comp. 121 bo 4 bwpd

J. E. TYRA

County Waubaussee State KansasSec. 2 (Blk. Twp.) 13 (Sur. Rge.) 10E Map No.Operator Skelly OilWell No. 3 Farm ThoeweElev. 1099 Location NW NE SE330 Ft. From N Line SE990 Ft. From E Line Quarter1st. Report DEC 6 1950

Completion

Remarks

Atkins - Contr.Spudding Date 12-1-50Orig. Data Mill Creek Pool8" @ 204 KC 1364 drig. 1510

J. E. TYRA