


KANSAS

Section 2 Township Waubaussee 13 Range 10E
 Well No. #4 C.Thoewe
 Company Skelly Oil

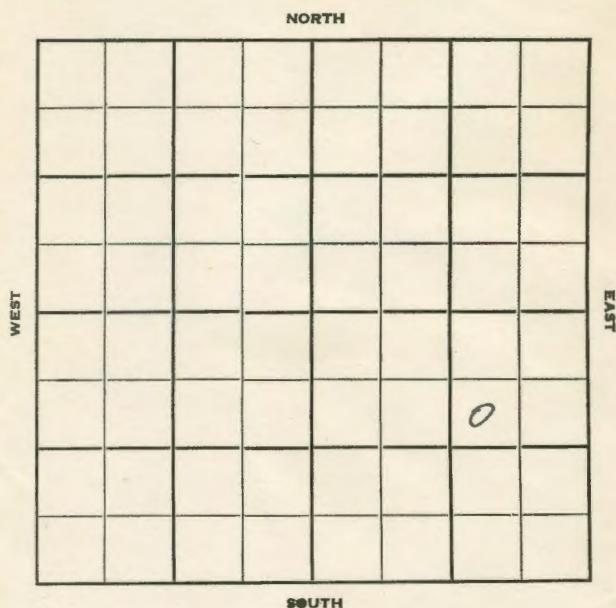

Waubaussee KANSAS 10E ✓

Sec. 2 Twp. 13 R. 10E
 Well No. #4 C. Thoewe Farm _____
Skelly Oil Company _____
Adkin Drlg. -Contr. Contractor _____
Mill Creek Pool


990' Ft. from N. Line

Ft. from S. Line

990' Ft. from E. Line

Ft. from W. Line

SW NE SE

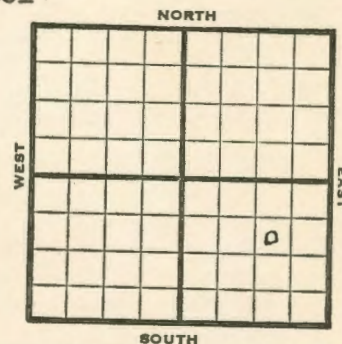

1950

Elev. -

REPORT

12/27

Spud 12-19-50

8" @ 202

Drlg. 1445'

2/28

Spud 12-19-50

Oil Well TD 2934

8" @ 202'

Top 644' Lans. 1223'

KC 1368 BKC 1582

Miss 2198 B. Miss 2488

Hunton 2684 Maq. 2852

Viola 2930-33

DST 2929-33 opn. 1 1/2 hr

Rec. 30' oil 5' ocm TD 2934

5" @ 2930 250 A P/200 bo 16 hr

Comp. draw down pot. 1156 bopd

COMPLETED

County **Waubaussee** State **Kansas**
 Sec. **2** (Blk. Twp.) **13** (Sur. Rge.) **10E** Map No.
 Operator **Skelly Oil**
 Well No. **4** Farm **C. Thoewe**
 Elev. Location **SW NE SE**

990 Ft. From **N** Line **SE**
990 Ft. From **E** Line Quarter
 1st. Report **DEC 27 1950**
 Completion
 Remarks
Adkins Drlg. - Contr.
 Spudding Date **12-19-50**
 Drlg. Data **Mill Creek Pool**
8" @ 202 drlg. 1445

J. E. TYRA

County **Waubaussee** State **Kansas**
 Sec. **2** (Blk. Twp.) **13** (Sur. Rge.) **10E** Map No.
 Operator **Skelly Oil**
 Well No. **4** Farm **C. Thoewe**
 Elev. Location **SW NE SE**

990 Ft. From **N** Line **SE**
990 Ft. From **E** Line Quarter
 1st. Report
 Completion **FEB 28 1951**
 Remarks **Mill Creek Pool**
Adkins Drlg. - Contr.
 Spudding Date **12-19-50**
 Drlg. Data **Oil well TD 2934**
8" @ 202 Top. 644 Lans. 1223 KC 1368
B KC 1582 Miss. 2198 B. Miss. 2488
Hunton 2684 Maq. 2852 Viola 2930-33
DST 2929-33 open 1½ hr. Rec. 30' oil
5' ocm TD 2934 5" @ 2930 250 A
P/ 200 bo 16 hr. Comp. draw down pot.
1156 bopd

J. E. TYRA