

15-197-0010

KANSAS


FORM 51 25M 3-49 PETROL

Section 6 Township 13 Range 10 E

Well No. 1 McComb

Company John Wengel et al

NORTH

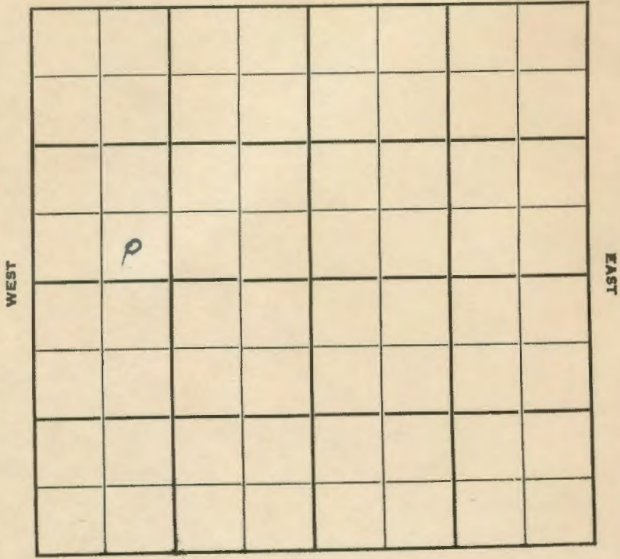

SOUTH

FORM 252-B
10M 9-49 PETROL

KANSAS

Waubaunsee

Sec. 6 Twp. 13 R. 10E

Well No. #1 McComb Farm

John Wengel et al Company

Sunflower Contractor

Ft. from N. Line


330 Ft. from S. Line

Ft. from E. Line

990 Ft. from W. Line

SE SW NW

NORTH

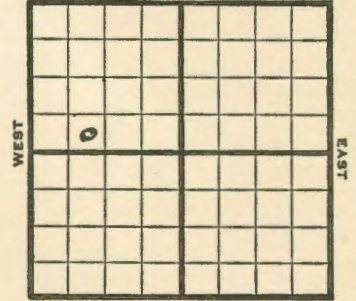

SOUTH

Elev. 1200' REPORT

1950

5/10 Spud 5-6-50
8 5/8 @ 67
Drlg. 1083

2396
1200
-1196

5/24 8-5/8" @ 67'

Howard 792'	Topeka 856'
Heebner 1168'	Lans. 1419'
KC 1544'	BKC 1784'
Cherokee 1987'	Miss Chat 2394'
Miss Lime 2396'	Hunton 2824'
Maq. 3075'	Viola 3148'
Simp Dol. 3217'	
Simp. sd 3250'	Arb. 3293'
TD 3307'	

NS
D&A

ABANDONED

Kansas

Map No. _____ Sec. 6 Twp. 13 R. 10E


Well No. 1 McComb

John Wengel etal Company

Sunflower Contractor

SE SW NW

SECTION PLAT

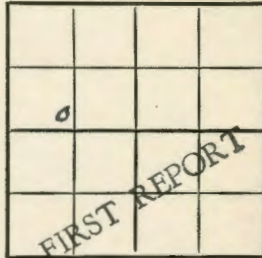

_____ Ft. from N. Line

330 Ft. from S. Line

_____ Ft. from E. Line

990 Ft. from W. Line

Waubaussee
~~Waubaussee~~

Location _____

RECORD

Cased _____ in., _____ ft.

Sand _____

Gas _____

Oil _____

Total Depth _____

PRODUCTION

1st 24 hrs. Nat. _____

1st 24 hrs. after shot _____

Gas _____ Cu. Ft.

Dry Hole _____

Abandoned _____

Date _____

MAY 3 0 1950

J. E. TYRA Scout

Kansas

Map No. _____ Sec. 6 Twp. 13 R. 10E

Well No. 1 McComb


John Wengel Etal. Company

Contractor

SE SW NW

E1.1200

SECTION PLAT

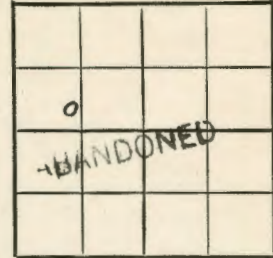

_____ Ft. from N. Line

330 Ft. from S. Line

_____ Ft. from E. Line

990 Ft. from W. Line

Waubaussee

Location _____

RECORD

Cased _____ in., _____ ft.

Sand _____

Gas _____

Oil _____

Total Depth _____

PRODUCTION

1st 24 hrs. Nat. _____

1st 24 hrs. after shot _____

Gas _____ Cu. Ft.

Dry Hole _____

Abandoned _____

Date _____

MAY 2 4 1950

J. E. TYRA Scout

Cherokee 1987
 Mass. Chat 2390
 Miss. Line 2390
 Hunton 2824
 Mag. 3075
 Viola 3148
 Simp. dol. 3217
 Simp. sd. 3250
 arb. 3293
 T.D. 3307
 N.S. D+A

Scout Cards
 Land Small Map
 Land Wall Map
 Tracings
 France Map
 Pierre Map
 Misc.

JUN 5 1950

RECORD

SECTION 15-1

Contractor

Company

Notes