FORM 51 25M 3-49 PETROL


KANSAS

Wabaunsee

Section 28 Township 13 Range 10-E

Well No. #1 G H Davis "C"

Company Carter Oil

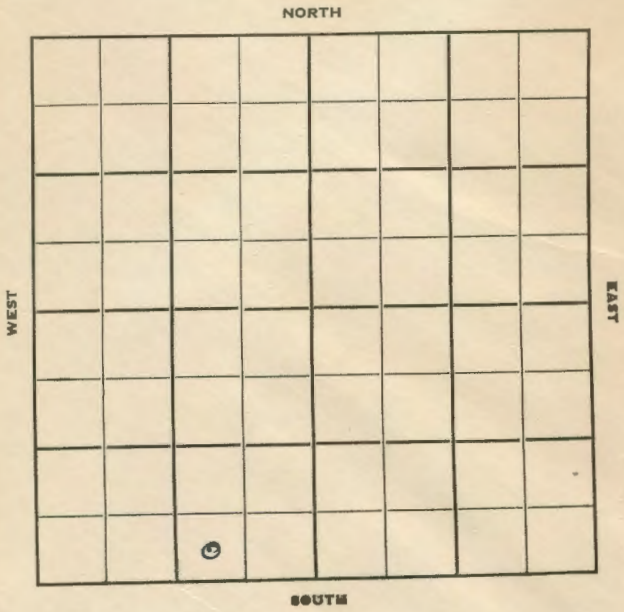

FORM 252-B
10M 9-49 PETROL

Wabaunsee KANSAS

Sec. 28 Twp. 13 R. 10E

Well No. #1 G. H. Davis "C" Farm

Carter Oil Company

Atikins Contractor

Davis Ranch


Ft. from N. Line

330' Ft. from S. Line

990' Ft. from E. Line

Ft. from W. Line

SW SE SW

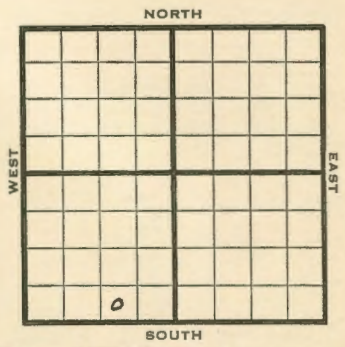

1950	REPORT
	Elev 1404'
2/15	Spud 2-10-50 8" @ 188' Howard 905' Topeka 963' Heebner 1272' Lans. 1546' KC 1684' Drlg. 1844'
3/29	TD 3192' 8"@ 188' 5½"@ 3186' Topeka 963' Heebner 1272' Lans 1546' Miss 2550' Viola 3182' 2911 BOPD Comp COMPLETED

How 905

Form 26 200 Bks. 11-49 Petrol — Kansas — Davis Ranch

Map No. ____ Sec. 28 Twp. 13 R. 10E


Well No. 1 G. H. Davis "C"

Carter Oil Company

Atikins Contractor

SW SE SW — El. 1404

SECTION PLAT

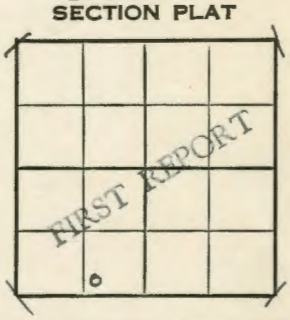

____ Ft. from N. Line

330 Ft. from S. Line

990 Ft. from E. Line

____ Ft. from W. Line

Wabaunsee County

Location ____

Rig up ____

Drilling and Remarks:

Spud 2-10-50
8" @ 188
Howard 905
Topeka 963
Heebner 1272
Lans. 1546
KC 1684
drlg. 1844

RECORD

Cased ____ in., ____ ft.
Sand ____
Gas ____
Oil ____
Total Depth ____

PRODUCTION

1st 24 hrs. Nat. ____
1st 24 hrs. after shot ____
Gas ____ Cu. Ft.
Dry Hole ____
Abandoned ____

Date FEB 15 1950 19 — J. E. TYRA Scout

Form 26 200 Bks. 11-49 Petrol — Kansas — Davis Ranch

Map No. ____ Sec. 28 Twp. 13 R. 10E


Well No. 1 G. H. Davis "C"

Carter Oil Company

Contractor

SW SE SW — El. 1404

SECTION PLAT

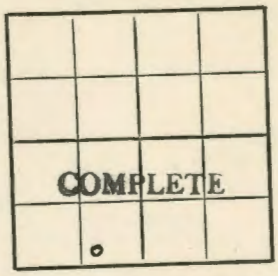

____ Ft. from N. Line

330 Ft. from S. Line

990 Ft. from E. Line

____ Ft. from W. Line

Wabaunsee County

Location ____

Rig up ____

Drilling and Remarks:

8" @ 188
5½ @ 3186
Topeka 963
Heebner 1272
Lans 1546
Miss 2550
Viola 3182
— 291 BOPD —

RECORD

Cased ____ in., ____ ft.
Sand ____
Gas ____
Oil ____
Total Depth 3192

PRODUCTION

1st 24 hrs. Nat. ____
1st 24 hrs. after shot ____
Gas ____ Cu. Ft.
Dry Hole ____
Abandoned ____

Date MAR 29 1950 19 — J. E. TYRA Scout