

KANSAS

Wabaunsee


Section 33 Township 13 Range 10E

Well No. 1 Davis GH Davis Consolidated

Company Carter

Wildcat

NORTH

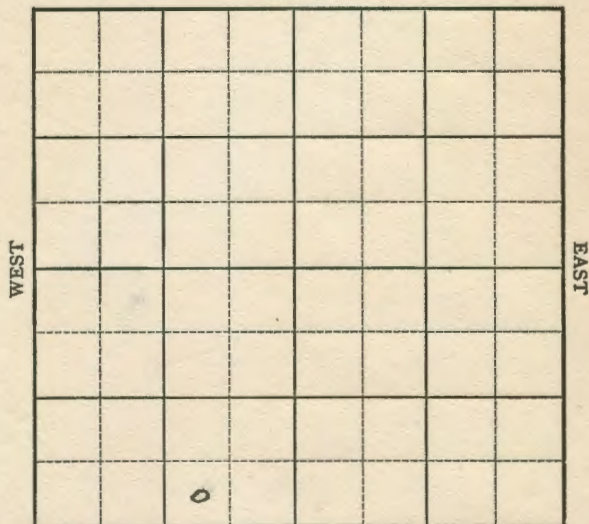

SOUTH

KANSAS

Wabaunsee

Sec. 33 Twp. 13 R. 10E

Well No. #1 Davis Farm

Carter Company

Wildcat


Ft. from N. Line

330' Ft. from S. Line

990' Ft. from E. Line

Ft. from W. Line

SW SE SW

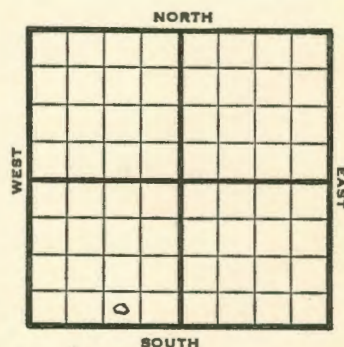

1949

Elev 1410'

REPORT

3/23

Location

3/30

RUR

4/6

10" @ 161'

4/12

Lansing 1520'

Drlg 1859'

4/20

BKC 1889'

Miss 2474'

Drlg 2880'

4/27

Hunton 2973'

Maquoketa 3121'

Viola 3199'

DST 3202-06'

TD 3206'

opn 1 1/2 hrs.

1900' oil

No water

7" @ 3201'

Brav 29°

5/4

Swb 30 bbls oil 1st hr

27 bbls 2nd hr.

Fsg swab.

5/10

5/18

1st 12 hrs. pumped 129 bbls oil
next 18 hrs. 145 bbls oil 29° Gr.

5/25

6/1

TD 3206'

Viola 3199'

8" @ 3201'

Echo Pot 2580 Oil

29° Gr.

Comp

COMPLETED

Map No. _____ Sec. 33 Twp. 13 R. 10EWell No. 1 Davis

Carter

Company

SW SE SW FIRST REPORT


Contractor

SECTION PLAT

_____ Ft. from N. Line

330 Ft. from S. Line990 Ft. from E. Line

_____ Ft. from W. Line

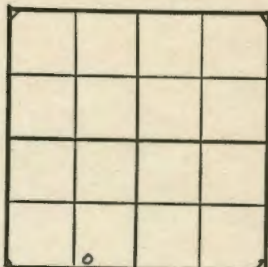

Wabaunsee County

Location X

RECORD

Cased _____ in., _____ ft.

Sand _____

Gas _____

Oil _____

Total Depth _____

PRODUCTION

1st 24 hrs. Nat. _____

1st 24 hrs. after shot _____

Gas _____ Cu. Ft.

Dry Hole _____

Abandoned _____

Date

MAR 23 1949

19

S. J. LEWIS

Scout

Map No. K99 Sec. 33 Twp. 13 R. _____Well No. 1 Davis

Carter

Company

COMPLETE

Contractor


SW SE SW

SECTION PLAT

_____ Ft. from N. Line

330 Ft. from S. Line990 Ft. from E. Line

_____ Ft. from W. Line

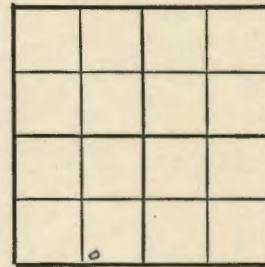

Wabaunsee County

Location _____

RECORD

Cased _____ in., _____ ft.

Sand _____

Gas _____

Oil _____

Total Depth 3246

PRODUCTION

1st 24 hrs. Nat. _____

1st 24 hrs. after shot _____

Gas _____ Cu. Ft.

Dry Hole _____

Abandoned _____

Date

JUN 1 1949

19

S. J. LEWIS

Scout