


15-197-00179  
 FORM 51 25M 8-50 WESTERN Waubaunsee KANSAS  
 Section 21 Township 13 Range 10E  
 Well No. #1 Hess  
 Company V. A. Brill

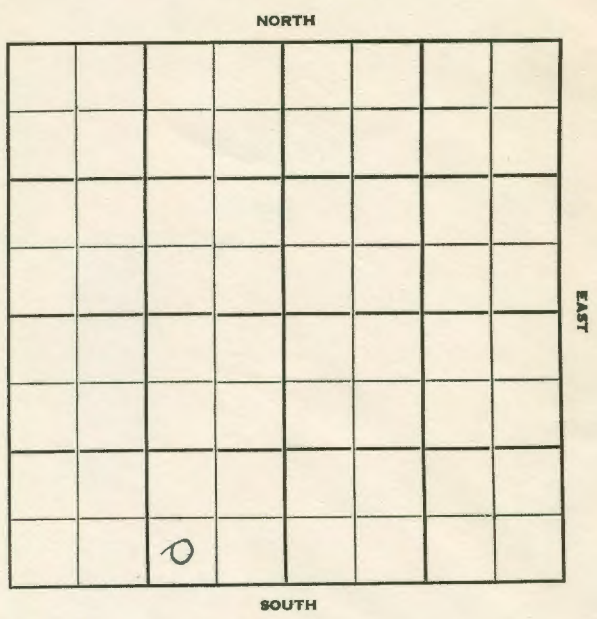

FORM 282-B  
 10N 11-50 PETROL Waubaunsee KANSAS  
 Sec. 21 Twp. 13 R. 10E ✓  
 Well No. #1 Hess Farm  
 V. A. Brill Company


Brown & Tomer Contractor

Davis Ranch Pool  
 Ft. from N. Line

330 Ft. from S. Line

1090 Ft. from E. Line

Ft. from W. Line

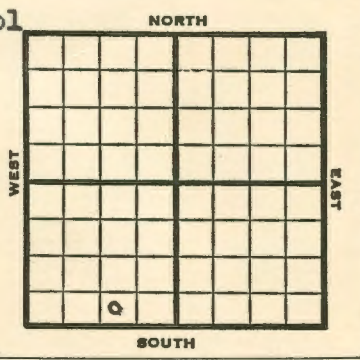

SW SE SW

Ohio farmout

1951 Elev. 1446' REPORT

3/21 Location  
 4/18 Spud 3-25-51  
 D & A TD 3370'  
 Heeb 1316', Lans. 1602', KC 1755',  
 B KC 1965', Miss 2551', Kinderhook  
 2976', Hunton 3066', Viola 3306'  
 TD 3370' D & A

**ABANDONED**

County Waubunsee State Kansas  
Sec. 21 (Blk. 13 (Twp.) (Sur. 10E Map No.  
Operator V. A. Brill  
Well No. 1 Farm Hess  
Elev. \_\_\_\_\_ Location SW SE SW

Grid with 'FIRST REPORT' stamp and '0' in the bottom left cell.

330 Ft. From S Line SW  
1090 Ft. From E Line Quarter  
1st. Report MAR 21 1951  
Completion \_\_\_\_\_  
Remarks Ohio farmout  
Brown & Tomer - Contr.  
Spudding Date \_\_\_\_\_

Drig. Data Davis Ranch Pool  
Location \_\_\_\_\_

J. E. TYRA

County Waubunsee State Kansas  
Sec. 21 (Blk. 13 (Twp.) (Sur. 10E Map No.  
Operator V. A. Brill  
Well No. 1 Farm Hess  
Elev. 1446 Location SW SE SW

Grid with 'ABANDONED' stamp and '0' in the bottom left cell.

330 Ft. From S Line SW  
1090 Ft. From E Line Quarter  
1st. Report \_\_\_\_\_  
Completion APR 18 1951  
Remarks Davis Ranch pool  
Brown & Tomer - Contr.  
Spudding Date 3-25-51

Drig. Data D & A TD 3370  
Heeb. 1316 Lans. 1602 KC 1755  
B KC 1965 Miss. 2551 Kinderhook 2976  
Hunton 3066 Viola 3306 TD 3370  
D & A

J. E. TYRA