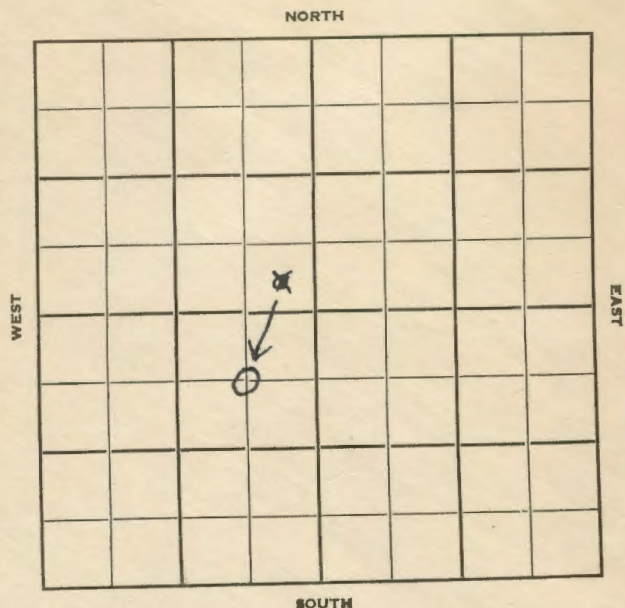


15-197-00090

KANSAS

FORM 51 25M 3-49 PETROL

Section 25 Township 13 Range 10EWell No. #1 BuckliCompany E1 Capitan

LES 1407

FORM 252-A
5M 10-48 PETROL

Wabaunsee

KANSAS

Sec. 25 Twp. 13 R. 10EWell No. #1 Buckli FarmE. Capitan Company


Wildcat

660 Ft. from N. Line~~330~~ Ft. from S. Line660
~~330~~ Ft. from E. Line

Ft. from W. Line

~~SE SE NW~~

C NE SW

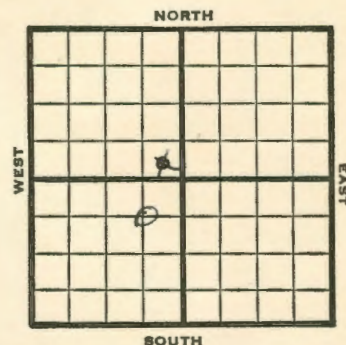

1950

EL 1407 REPORT

1/4 Setting surface pipe

2/15 TD 3518'
10" @ 194'

KC 1708'

BKC 1939

Miss 2610'

Hunton 3108'

Viola 3319'

Arb. 3518'

D&A

Aband.

ABANDONED

1939
1407
532

Kansas

Map No. _____ Sec. 25 Twp. 13 R. 10E

Well No. 1 Buckli

El Capitan Company

Contractor

SE SE NW

SECTION PLAT



Ft. from N. Line

330 Ft. from S. Line

330 Ft. from E. Line

Ft. from W. Line

Wabaunsee County

Location

Rig up

Drilling and Remarks:

Setting surface
pipe

RECORD

Cased in, ft.

Sand

Gas

Oil

Total Depth

PRODUCTION

1st 24 hrs. Nat.

1st 24 hrs. after shot

Gas Cu. Ft.

Dry Hole

Abandoned

Date

JAN 4 1950

19

Scout

Kansas

Map No. _____ Sec. 25 Twp. 13 R. 10E

Well No. 1 Buckli

El Capitan Company


Company

CORRECTION

Contractor

C NE SW

SECTION PLAT

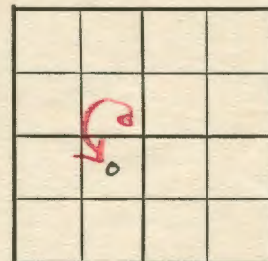

660 Ft. from N. Line

Ft. from S. Line

660 Ft. from E. Line

Ft. from W. Line

Wabaunsee County

Location

Rig up

Drilling and Remarks:

Reported

SE SE NW

RECORD

Cased in, ft.

Sand

Gas

Oil

Total Depth

PRODUCTION

1st 24 hrs. Nat.

1st 24 hrs. after shot

Gas Cu. Ft.

Dry Hole

Abandoned

Date

JAN 25 1950

19

J. E. TYRA

Scout

Wildcat


Kansas

Map No. _____ Sec. 25 Twp. 13 R. 10EWell No. 1 BuckliEl Capitan Company

Contractor

C NE SW

SECTION PLAT

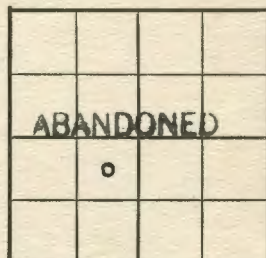660 Ft. from N. Line550 Ft. from S. Line660 Ft. from E. Line550 Ft. from W. Line

Wabaunsee County

Location

Rig up

Drilling and Remarks:

10" @ 194K.C. 17083XC 1939Miss 2610Hunter 3108Viola 3319Ans 3518

Date

FEB 15 1950

19

J. E. TYRA

Scout

RECORD

Cased _____ in. _____ ft.

Sand _____

Gas _____

Oil _____

Total Depth 3518

PRODUCTION

1st 24 hrs. Nat. _____

1st 24 hrs. after shot _____

Gas _____ Cu. Ft.

Dry Hole _____

Abandoned _____