FORM 51 25M 3-49 PETROL


KANSAS

Wabaunsee

Section 28 Township 13 Range 10-E

Well No. #3 Davis (C)

Company Carter Oil

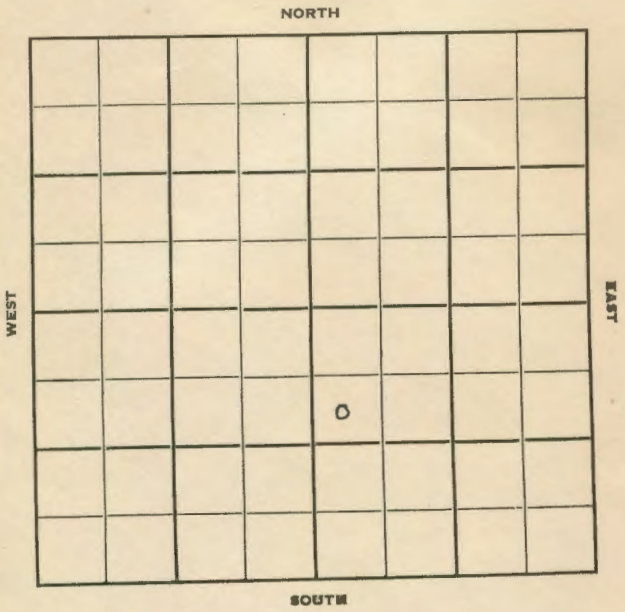

FORM 252-B
10M 9-49 PETROL

Wabaunsee KANSAS

Sec. 28 Twp. 13 R. 10E

Well No. #3 Davis (C) Farm

Carter Oil Company

Contractor


990' Ft. from N. Line

Ft. from S. Line

Ft. from E. Line

330' Ft. from W. Line

SW NW SE

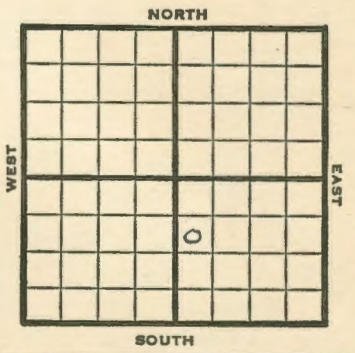

1950	REPORT
	Elev 1339
5/24	Location
7/26	8 5/8" @ 183
	Howard 844 Top 905
	Heeb 1220 Lans 1482
	KC 1625 B KC 1837
	Miss chat 2418 Miss lime 2422
	Kinderhook 2715 Hunton2901
	Maq 3051 Viola 3129
	DST 3130-37 opn 2 hr rec 2740' oil
	240' mud
	TD 3139
	5" @ 3130
	FU 2700' oil
	S/26 bo 2 hr
	Comp 83 bopd
	Completed
	COMPLETED

Form 26 200 Bks. 11-49 Petrol

Kansas

Map No. ____ Sec. 28 Twp. 13 R. 10E

Well No. 3 Davis (C)

Carter Oil Company

Contractor

SW NW SE

SECTION PLAT

990 Ft. from N. Line

Ft. from S. Line

Ft. from E. Line

330 Ft. from W. Line



Wabaunsee

Location X

Rig up

Drilling and Remarks:

RECORD

Cased ____ in., ____ ft.

Sand

Gas

Oil

Total Depth

PRODUCTION

1st 24 hrs. Nat.

1st 24 hrs. after shot

Gas ____ Cu. Ft.

Dry Hole

Abandoned

Date

MAY 24 1950 19

J. E. TYRA Scout

Form 26 200 Bks. 11-49 Petrol

Kansas

Map No. ____ Sec. 28 Twp. 13 R. 10E

Well No. 3 Davis "C"

Carter Oil Company

Contractor

SW NW SE

El. 1339


SECTION PLAT

990 Ft. from N. Line

Ft. from S. Line

Ft. from E. Line

330 Ft. from W. Line

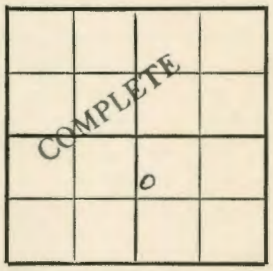

Waubaunsee County

Location

Rig up

Drilling and Remarks:

8 5/8" @ 183

Howard 844

Top. 905

Heeb. 1220

Lans. 1482

KC 1625

B KC 1837

RECORD

Cased ____ in., ____ ft.

Sand

Gas

Oil

Total Depth 3139

PRODUCTION

1st 24 hrs. Nat.

1st 24 hrs. after shot

Gas ____ Cu. Ft.

Dry Hole

Abandoned

Date

JUL 26 1950 19

J. E. TYRA Scout

Miss. chat 2418

Miss. lime 2422

Kinderhook 2715

Hunton 2901

Maq. 3051

Viola 3129

DST 3130-37

open 2 hr.

Rec. 2740' oil 240' mud

TD 3139

5" @ 3130

FU 2700' oil

S/ 26 bo 2 hr.

Comp. 83 bopd



Misc.
Pierce Map
France Map
Tracings
Land Wall Map
Land Small Map
Scout Cards