

KANSAS

Wabaunsee


Section 33 Township 13 Range 10E

Well No. 4 Davis "A"

Company Carter

Davis

NORTH

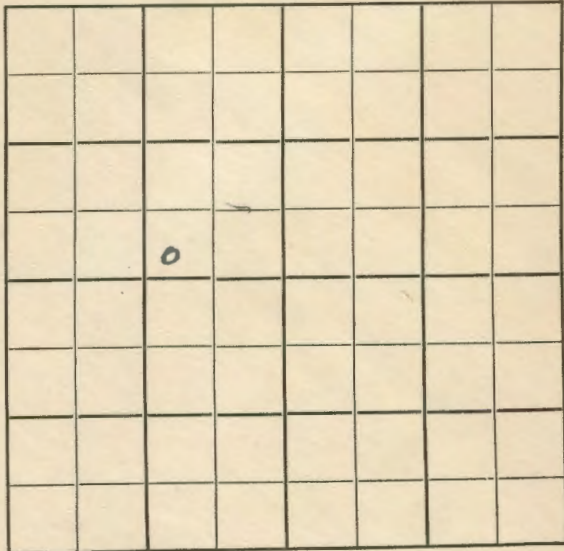

SOUTH

Wabaunsee **KANSAS**

Sec. 33 Twp. 13 R. 10E

Well No. #4 Davis "A" Farm

Carter Company

Davis Pool (Adkins Drlg., Contg.)

_____ Ft. from N. Line

330'


_____ Ft. from S. Line

990'

_____ Ft. from E. Line

_____ Ft. from W. Line

SW SE NW

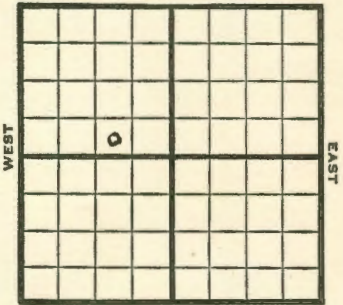

SOUTH

1949 ^W lev 1417' REPORT

8/31 Location
 9/7 10" @ 182'
 9/14 Howard 909'
 Topeka 972'
 Lansing 1558'
 BKC 1910'
 Drlg 2372'
 9/21 Miss 2487'
 Hunton 2968'
 Viola 3186'
 TD 3208'
 Run 7"
 9/28 7" @ 3188'
 10/5 Swb 436 bbls oil 6 hrs.
 10/12 "
 10/19 TD 3208'
 Viola 3186'
 7" @ 3188'
 Echo Pot 3000 Oil
 27⁸ Gr.
 Comp
COMPLETED

Map No. _____ Sec. 33 Twp. 13 R. 10E

Well No. 4 Davis "A"

Carter _____ Company

Adkins Drlg. _____ Contractor

SW SE NW

FIRST REPORT
SECTION PLAT

	o		

_____ Ft. from N. Line

330 Ft. from S. Line

990 Ft. from E. Line

_____ Ft. from W. Line

Wabaunsee County

Location X

RECORD

Cased _____ in., _____ ft.

Sand _____

Gas _____

Oil _____

Total Depth _____

PRODUCTION

1st 24 hrs. Nat. _____

1st 24 hrs. after shot _____

Gas _____ Cu. Ft.

Dry Hole _____

Abandoned _____

Date

AUG 31 1949 19

S. J. LEWIS Scout

Map No. _____ Sec. 33 Twp. 13 R. 10E

Well No. 4 Davis "A"

Carter _____ Company

COMPLETE _____ Contractor

SW SE NW

E1 1412
SECTION PLAT

	o		

_____ Ft. from N. Line

330 Ft. from S. Line

990 Ft. from E. Line

_____ Ft. from W. Line

Wabaunsee County

Location _____

RECORD

Cased _____ in., _____ ft.

Sand _____

Gas _____

Oil _____

Total Depth 215

PRODUCTION

1st 24 hrs. Nat. _____

1st 24 hrs. after shot _____

Gas _____ Cu. Ft.

Dry Hole _____

Abandoned _____

Date

OCT 19 1949 19

S. J. LEWIS Scout