

KANSAS

Wabaunsee

FORM 51 25M 3-49 PETROL

FORM 252-A
5M 10-48 PETROL

Wabaunsee

KANSAS

10E


Section 33 Township 13 Range 10-ESec. 33 Twp. 13 R. 10EWell No. #6 Davis "A"Well No. #6 Davis "A" FarmCompany Carter

Carter Company

Davis Ranch Pool

Davis Ranch Pool

NORTH

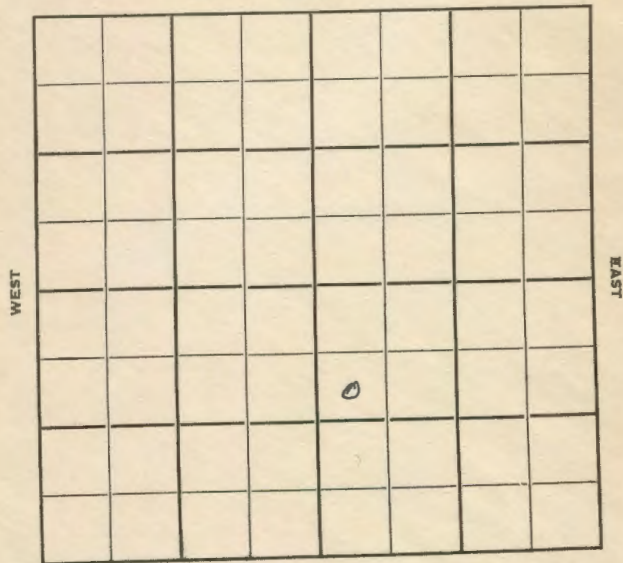

SOUTH


990' Ft. from N. Line

Ft. from S. Line

Ft. from E. Line

330' Ft. from W. Line

SW NW SE

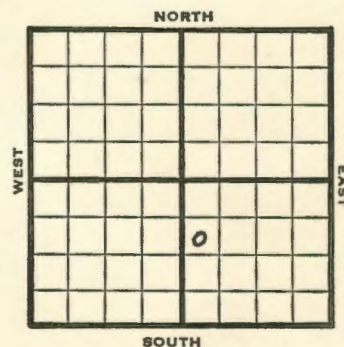

1949

Elev 1422'

REPORT

11/30

Location

12/7

Mach

12/14

Drlg. 185'

12/21

425 SD

12/28

13"@ 546'

1950

4/12

TD 3191'

13"@ 546'

10 3/4" @ 1134'

Lans 1533'

BKC 1889'

Miss 2472'

Viola 3175'

5 1/2" @ 3177'

2990 BOPD

Comp

COMPLETED

Kansas

Map No. _____ Sec. 33 Twp. 13 R. 10EWell No. 6 Davis "A"

Carter _____ Company

Contractor

SW NW SE

E.I. 1422
SECTION PLAT990 Ft. from N. Line

_____ Ft. from S. Line

_____ Ft. from E. Line

330 Ft. from W. Line

COMPLETE

Wabaunsee County

Location _____

Rig up _____

Drilling and Remarks:

13" @ 54610 3/4" @ 1134Lans 1533BXC 1889Miss 2472Viola 3175

RECORD

Cased _____ in., _____ ft.

Sand _____

Gas _____

Oil _____

Total Depth 3191

PRODUCTION

1st 24 hrs. Nat. _____

1st 24 hrs. after shot _____

Gas _____ Cu. Ft.

Dry Hole _____

Abandoned _____

5 1/2" @ 3177Date 2990 BOPD

APR 12 1950

19

J. E. TYRA Scout

Map No. _____ Sec. 33 Twp. 13 R. 10EWell No. 6 Davis "A"

Carter _____ Company

Contractor

SW NW SE

FIRST REPORT
SECTION PLAT990 Ft. from N. Line

_____ Ft. from S. Line

_____ Ft. from E. Line

330 Ft. from W. Line

Wabaunsee County

Location X

Rig up _____

Drilling and Remarks:

RECORD

Cased _____ in., _____ ft.

Sand _____

Gas _____

Oil _____

Total Depth _____

PRODUCTION

1st 24 hrs. Nat. _____

1st 24 hrs. after shot _____

Gas _____ Cu. Ft.

Dry Hole _____

Abandoned _____

Date

NOV 30 1949

19

S. J. LEWIS Scout