
FORM 51 25M 3-49 PETROL KANSAS Wabaunsee

Section 33 Township 13 Range 10E

Well No. 3 Davis "A"

Company Carter

Davis Ranch

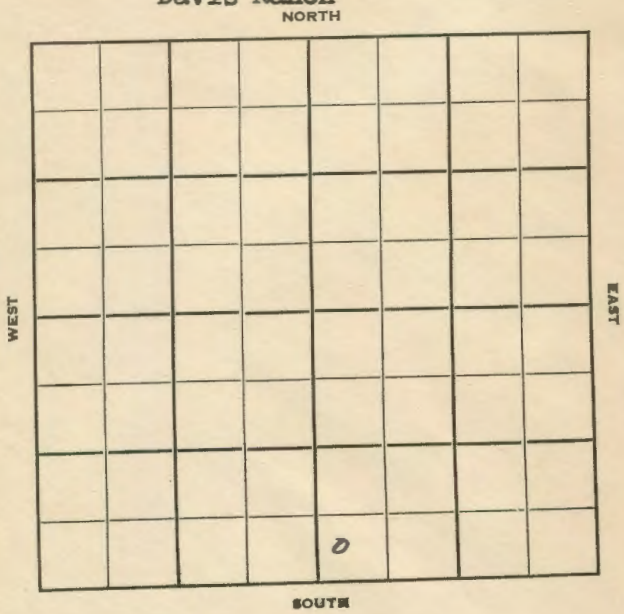

FORM 252-A
5M 10-48 PETROL

Wabaunsee KANSAS

Sec. 33 Twp. 13 R. 10E

Well No. #3 Davis "A" Farm

Carter Company

Davis Ranch Pool


_____ Ft. from N. Line

330' Ft. from S. Line

_____ Ft. from E. Line

330' Ft. from W. Line

SW SE

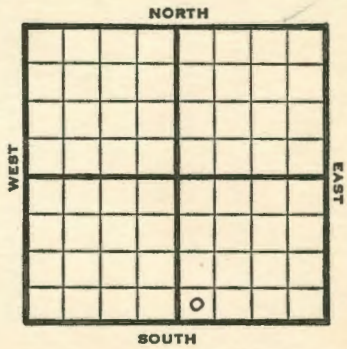

1949	Elev 1406' REPORT
8/10	Location
8/17	10"@ 181'
8/24	Topeka 942
	Lansing 1522
	KO 1664
	BKC 1876
	Drlg. 2360
8/31	Miss 2468'
	Hunton 2944'
	Viola 3168'
	TD 3190'
	Ran csg.
9/7	7" @ 3170'
9/14	Swb 294 bbls oil in 7 hrs.
9/21	TD 3191'
	Viola 3168'
	7"@ 3170'
	Echo Pot 3000 Oil
	27° Gr.
	Comp
	COMPLETED

Form 26 200 Bks. 6-49 Petrol
Kansas

Davis Ranch Pool

Map No. 1599 Sec. 33 Twp. 13 R. 10E

Well No. 3 Davis "A"


Carter Company

COMPLETE Contractor

SW SE

El. 1406

SECTION PLAT

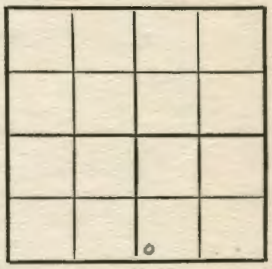

Ft. from N. Line

330 Ft. from S. Line

Ft. from E. Line

330 Ft. from W. Line

Wabaunsee County

Location

Rig up

Drilling and Remarks:

Vis la 3185.
7" @ 3178
Ech w/ 2 1/2 300 sacks

27 Bbls

RECORD

Cased in., ft.
Sand
Gas
Oil
Total Depth 3191

PRODUCTION

1st 24 hrs. Nat.
1st 24 hrs. after shot
Gas Cu. Ft.
Dry Hole
Abandoned

Date

SEP 21 1949 19

S. J. LEWIS Scout

Form 26 200 Bks. 6-49 Petrol
Kansas

Davis Ranch Pool

Map No. Sec. 33 Twp. 13 R. 10E

Well No. 3 Davis "A"


Carter Company

Contractor

SW SE

FIRST REPORT

SECTION PLAT

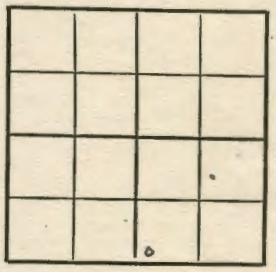

Ft. from N. Line

330 Ft. from S. Line

Ft. from E. Line

330 Ft. from W. Line

Wabaunsee County

Location x

Rig up

Drilling and Remarks:

RECORD

Cased in., ft.
Sand
Gas
Oil
Total Depth

PRODUCTION

1st 24 hrs. Nat.
1st 24 hrs. after shot
Gas Cu. Ft.
Dry Hole
Abandoned

Date

AUG 10 1949 19

S. J. LEWIS Scout