

Section **33** Township **13** Range **10E**Well No. **#5 Davis "A"**Company **Carter**Sec. **33** Twp. **13** R. **10E**Well No. **#5 Davis "A"** FarmCompany **Carter**

Contractor

Davis Ranch Pool



990' Ft. from N. Line

Ft. from S. Line

990' Ft. from E. Line

Ft. from W. Line

SW NE NW

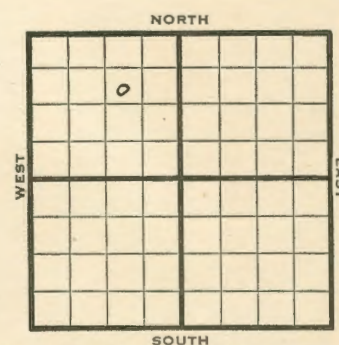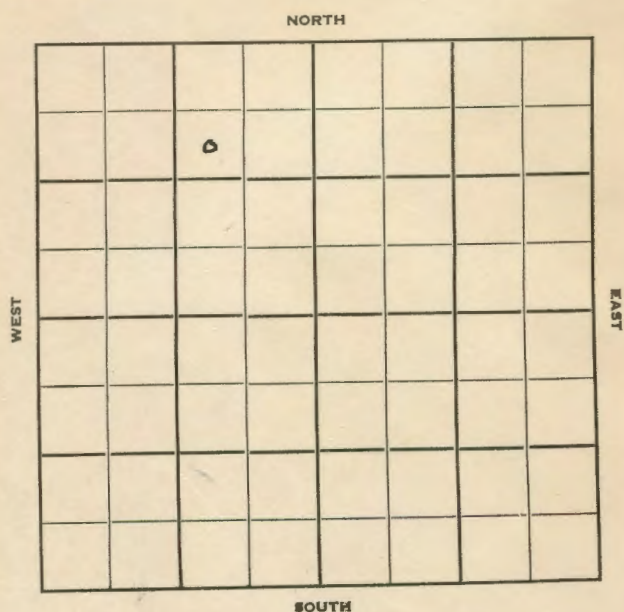

1949	Elev 1425'	REPORT
11/2	Location	
11/9	"	
11/16	"	
11/23	Surface hole	
11/29	10" @ 182'	
	Howard 906'	
	Lansing 1550'	
	KC 1692'	
	Drlg 1710'	
12/7	BKC 1890'	
	Hunton 2969'	
	Drlg 2984'	
12/14	Viola 3180'	
	TD 3203'	
	7" @ 3182'	
12/21	2800' oil 2 hrs	
12/28	"	
1950		
1/11	10" @ 182'	
	7" @ 3182'	
	PP 474 BOPD	
	Potential 3000' BOPD	
	Gr 30.2	BKC 1890'
	Howard 906'	Miss 2503'
	Topk 966'	Kinderhook 2776'
	Lan 1550'	Hunton 2969-2984'
	KC 1692'	Viola 3180-3203 TD
	Comp	COMPLETED

Map No. _____ Sec. 33 Twp. 13 R. 10E

Well No. 5 Davis "A"

Carter

Company

Contractor

SW NE NW

FIRST REPORT
SECTION PLAT

990 Ft. from N. Line

Ft. from S. Line

990 Ft. from E. Line

Ft. from W. Line

Wabaunsee County

Location X

Rig up

Drilling and Remarks:

RECORD

Cased _____ in., _____ ft.

Sand _____

Gas _____

Oil _____

Total Depth _____

PRODUCTION

1st 24 hrs. Nat. _____

1st 24 hrs. after shot _____

Gas _____ Cu. Ft.

Dry Hole _____

Abandoned _____

Date

NOV 2 1949 19

S. J. LEWIS

Scout

Map No. _____ Sec. 33 Twp. 13 R. 10E

Well No. 5 Davis "A"

Carter

Company

Contractor

SW NE NW

Edw. 1425
SECTION PLAT

990 Ft. from N. Line

Ft. from S. Line

990 Ft. from E. Line

Ft. from W. Line

COMPLETE

Wabaunsee County

Location

Rig up

Drilling and Remarks:

10" @ 182

7" @ 3182

PP 474 BOPD

Potential 3000

BOPD

Gr. 30.2

RECORD

Cased _____ in., _____ ft.

Sand _____

Gas _____

Oil _____

Total Depth _____

PRODUCTION

1st 24 hrs. Nat. _____

1st 24 hrs. after shot _____

Gas _____ Cu. Ft.

Dry Hole _____

Abandoned _____

Date

JAN 11 1950 19

J. E. TYRA

Scout

check spot 1st report
shows sw ne nw

Howard 906 actual

Jopk 966 same

Lan 1550

K.C. 1692

B.K.C. 1890

Miss 2503

Kinderhook 2776

Huntow 2969-2984

Virlo 3180-3203 T.D.

Scout Cards
Land Small Map
Land Wall Map
Tracings
France Map
Pierce Map
Misc.

JAN 10th 1890