


Wabaunsee

KANSAS

Section 33 Township 13 Range 10-EWell No. #11 Davis "A"Company Carter Oil

NORTH

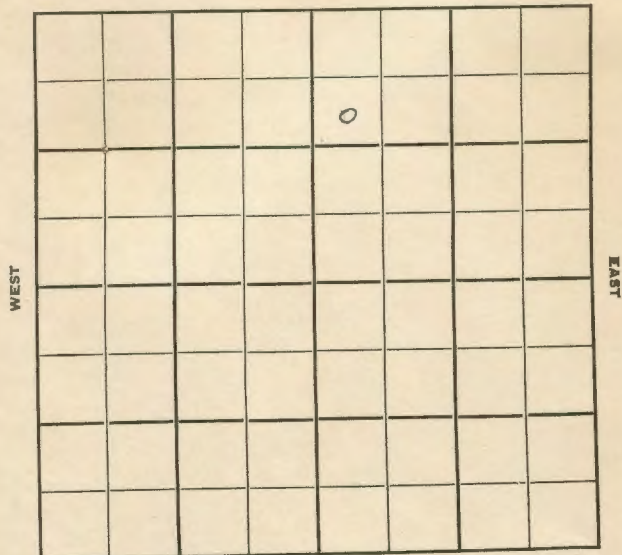

SOUTH

Wabaunsee

KANSAS

Sec. 33 Twp. 13 R. 10EWell No. #11 Davis "A" FarmCompany Carter Oil

Contractor

Davis Ranch Pool

990' Ft. from N. Line


Ft. from S. Line

Ft. from E. Line

330' Ft. from W. Line

SW NW NE

NORTH

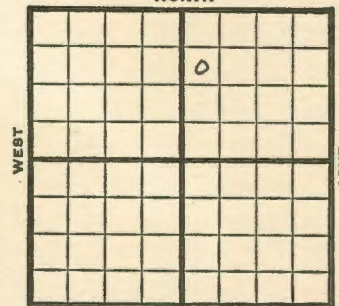

SOUTH

1950

Elev. 1423'

REPORT

4/5

Spud 4-2-50

8-5/8" @ 183'

Drlg. 575'

5/31

8-5/8" 183'

Howard 898'

Topeka 960'

Heeb 1265'

Lans. 1537

KC 1678'

BKC 1891'

Miss 2482'

DST 23933-38

Rec. 510' heavy oil & 60' OGM

DST 2938-43

Rec. 750' heavy oil & 30' OCM

DST 2943-49

Rec. 425' oil & 420' OCM

DST 2949-54

Rec. 30' OCM

Maq 3083'

Viola 3160'

5 1/2" @ 3163 TD 3182'

Comp. 3000 BOPD

Dolomite 2487'

Kinderhook 2749'

Hunton 2931'

COMPLETED

Kansas

Davis Ranch Pool

Map No. _____ Sec. 33 Twp. 13 R. 10E

Well No. 11 Davis "A"

Carter Oil _____ Company

Contractor _____

SW NW NE

SECTION PLAT

990 Ft. from N. Line

Ft. from S. Line

Ft. from E. Line

330 Ft. from W. Line

		0	

FIRST REPORT

Wabaunsee County

Location _____

RECORD

Rig up _____

Drilling and Remarks:

Spud 4-2450

8 5/8" @ 183

drlg. 575

Cased _____ in. _____ ft.

Sand _____

Gas _____

Oil _____

Total Depth _____

PRODUCTION

1st 24 hrs. Nat. _____

1st 24 hrs. after shot _____

Gas _____ Cu. Ft.

Dry Hole _____

Abandoned _____

Date

APR 5 1950

19

J. E. TYRA Scout

Kansas

Davis Ranch Pool

Map No. _____ Sec. 33 Twp. 13 R. 10E

Well No. 11 Davis "A"

Carter Oil _____ Company

Contractor _____

SW NW NE

E1. 1423

SECTION PLAT

990 Ft. from N. Line

Ft. from S. Line

Ft. from E. Line

330 Ft. from W. Line

		0	

COMPLETE

Wabaunsee

Location _____

RECORD

Rig up _____

Drilling and Remarks:

8 5/8" C 183

Howard 898

Dopeka 960

Karb. 1265

Lane. 1537

K.C. 1678

BKC. 1891

Miss. 3482

Date

MAY 31 1950

19

J. E. TYRA Scout

Cased _____ in. _____ ft.

Sand _____

Gas _____

Oil _____

Total Depth 3182

PRODUCTION

1st 24 hrs. Nat. _____

1st 24 hrs. after shot _____

Gas _____ Cu. Ft.

Dry Hole _____

Abandoned _____

allolomite 2487
Kinderhook 2749
Huntsen 2931

DST 2933-38

Rec. 510' heavy oil $\pm$ 60' ocm

DST 2938-43

Rec. 750' heavy oil $\pm$ 30' ocm

DST 2943-49

Rec. 425' oil $\pm$ 420' ocm

DST 2949-54

Rec. 30' ocm

Mag. 3083

Vibla 3160

5 1/2" c 3163

TD. 3182

Comp. 3000 bpsd

Misc.
Pierce Map
France Map
Tracings
Land Wall Map
Land Small Map
Scout Cards

1960 6 NINE

SECTION 1714

LOCATION

COMPUTED

DATE

TIME

BY

DATE