


Section 33 Township 13 Range 10-EWell No. #12 Davis "A"Company Carter Oil

NORTH

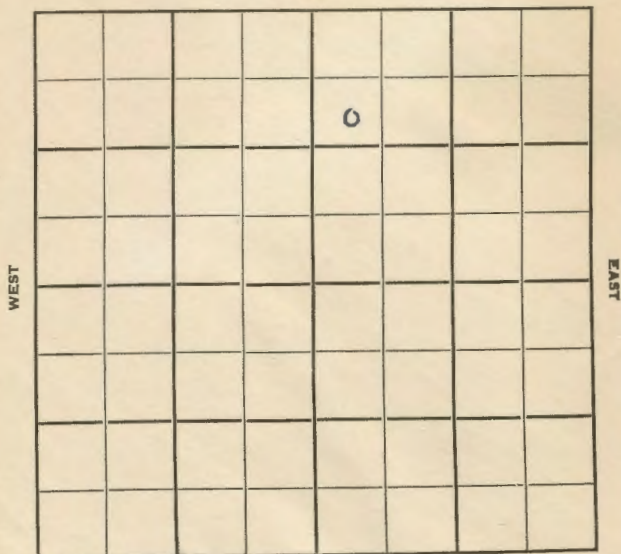

SOUTH

Sec. 33 Twp. 13 R. 10-EWell No. #12 Davis "A" Farm

Carter Oil Company

Transit Drlg. Contractor

Davis Ranch

1040 Ft. from N. Line


Ft. from S. Line

Ft. from E. Line

330 Ft. from W. Line

SW NW NE Twin to #11

NORTH

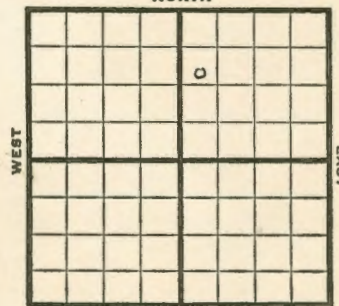

SOUTH

1950

Elev. - REPORT

11/8

Spud 11-5-50
8" @ 165'1951
1/10

Spud 11-5-50
Oil Well TD 2941
8" @ 165' Lans. 1535' KC 1678'
SO 1851-60
DST 1851-62 opn 2 hr Rec. 125' hoem
BKC 1891 Hunton 2930-41 TD
5½" @ 2929 CO to 2941
B/1¼ boph 200 A
14/2929-38 B/1½ bwph SSO
500 A S/32 bo 121 bw 12 hr
PB 2936 154 bo 394 bw
Comp. 44 bo 176 bwpd

COMPLETED

County Waubaussee State Kansas
 Sec. 33 (Blk. 13 (Sur. 10E Map No.
 Operator Carter Oil
 Well No. 12 Farm Davis "A"
 Elev. _____ Location SW NW NE (twin to #11)
 1040 Ft. From N Line NE
 330 Ft. From W Line Quarter
 1st. Report NOV 8 1950
 Completion _____
 Remarks Transit Drlg. - Contr.
 Spudding Date 11-5-50
 Drlg. Data Davis Ranch Pool
8" @ 165

J. E. TYRA

County Waubaussee State Kansas
 Sec. 33 (Blk. 13 (Sur. 10E Map No.
 Operator Carter Oil
 Well No. 12 Farm Davis "A"
 Elev. _____ Location SW NW NE (twin well)
 1040 Ft. From N Line NE
 330 Ft. From W Line Quarter
 1st. Report _____
 Completion JAN 10 1951
 Remarks Davis Ranch Pool
Transit Drlg. - Contr.
 Spudding Date 11-5-50
 Drlg. Data Oil well TD 2941
8" @ 165 Lans. 1535- KC 1678 SO 1851-
60 DST 1851-62 open 2 hr. Rec. 125'
hocm B KC 1891 Hunton 2930-41 TD 5½" @
2929 CO to 2941 B/ 1¼ boph 200 A
14/ 2929-38 B/ 1½ bwph SSO 500 A
S/ 32 bo 121 bw 12 hr. PB 2936
154 bo 394 bw Comp. 44 bo 176 bwph

J. E. TYRA