

34-13-12E

TYPE

AFFIDAVIT OF COMPLETION FORM

ACO-1 WELL HISTORY

Compt. _____

SIDE ONE

State Geological Survey

WICHITA BRANCH

(Rules 82-3-130 and 82-3-107)

This form shall be filed with the Kansas Corporation Commission, 200 Colorado Derby Building, Wichita, Kansas 67202, within ninety (90) days after the completion of a well, regardless of how the well was completed.

FOR INFORMATION REGARDING THE NUMBER OF COPIES TO BE FILED AND APPLICATIONS REQUIRING COPIES OF ACO-1 FORMS SEE PAGE TWO (2), SIDE TWO (2) OF THIS FORM.

F _____ Letter requesting confidentiality attached.

C _____ Attach ONE COPY of EACH wireline log run (i.e. electrical log, sonic log, gamma ray neutron log etc.)***Check here if NO logs were run _____.

PLEASE FILL IN ALL INFORMATION. IF NOT AVAILABLE, INDICATE. IF INFORMATION LATER BECOMES AVAILABLE, SUBMIT BY LETTER.

LICENSE # 5118 EXPIRATION DATE 6-30-84

OPERATOR TGT Petroleum Corp. API NO. NONE *PAID-KCC*

ADDRESS 209 E. William COUNTY Wabaunsee

Wichita, Kansas 67202 FIELD _____

** CONTACT PERSON B. Lynn Herrington PROD. FORMATION _____

PHONE 262-6489

PURCHASER _____ LEASE Eskridge

ADDRESS _____ ~~WELL NO.~~ Core Hole #40

DRILLING TGT Petroleum Corp. WELL LOCATION SE/4

CONTRACTOR 209 E. William 1360 Ft. from S Line and

ADDRESS Wichita, Kansas 67202 1260 Ft. from E Line of (E)

PLUGGING TGT Petroleum Corp. the SE (Qtr.) SEC 34 TWP 13S RGE 12 (N).

CONTRACTOR _____

ADDRESS _____

TOTAL DEPTH 820 PBD _____

SPUD DATE 8-8-83 DATE COMPLETED 8-11-83


ELEV: GR _____ DF _____ KB _____

DRILLED WITH (CABLE) (ROTARY) (AIR) TOOLS.

DOCKET NO. OF DISPOSAL OR REPRESSURING WELL BEING USED TO DISPOSE OF WATER FROM THIS LEASE _____

WELL PLAT

(Office Use Only)

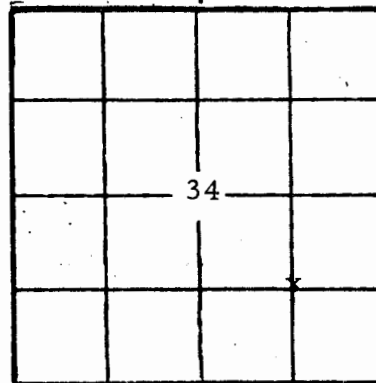

KCC _____
KGS ☒
SWD/REP _____
PLG. _____
NGPA _____

Amount of surface pipe set and cemented NONE *See 34* DV Tool Used? _____

TYPE OF COMPLETION THIS AFFIDAVIT APPLIES TO: (Circle ONE) - Oil, Shut-in Gas, Gas, Dry, Disposal, Injection, Temporarily Abandoned. If OWWO, indicate type of re-completion _____. Other completion Core Hole. NGPA filing _____.

ALL REQUIREMENTS OF THE STATUTES, RULES AND REGULATIONS PROMULGATED TO REGULATE THE OIL AND GAS INDUSTRY HAVE BEEN FULLY COMPLIED WITH.

A F F I D A V I T

B. Lynn Herrington, being of lawful age, hereby certifies that:

I am the Affiant, and I am familiar with the contents of the foregoing Affidavit. The statements and allegations contained therein are true and correct.

SIDE TWO

OPERATOR TGT Petroleum Corp. LEASE EskridgeACO-1 WELL HISTORY (E)
SEC. 34 TWP. 13SRGE. 12 (10)

FILL IN WELL INFORMATION AS REQUIRED:

WELLSITE Core Hole #40

Show all important zones of porosity and contents thereof; cased intervals, and all drill-stem tests, including depth interval tested, cushion used, time tool open, flowing and shut-in pressures, and recoveries.

SHOW GEOLOGICAL MARKERS, LOGS RUN, OR OTHER DESCRIPTIVE INFORMATION.

FORMATION DESCRIPTION, CONTENTS, ETC.	TOP	BOTTOM	NAME	DEPTH
Check if no Drill Stem Tests Run.				
Check if samples sent to Geological Survey				
Clay	0	12		
Rock & Clay	12	30		
Blue Shale	30	85		
Red Bed	85	95		
Blue Shale	95	175		
Bentonite	175	180		
Blue Shale	180	215		
Bentonite	215	230		
Shale & Lime	230	465		
Bentonite	465	525		
Shale & Lime	525	720		
Bentonite	720	750		
Shale & Lime	750	820		

State Geological Survey
WICHITA BRANCH

If additional space is needed use Page 2,

Report of all strings set—surface, intermediate, production, etc. CASING RECORD (New) or (Used)

Purpose of string	Size hole drilled	Size casing set (in O.D.)	Weight lbs/ft.	Setting depth	Type cement	Sacks	Type and percent additives

LINER RECORD

PERFORATION RECORD

Top, ft.	Bottom, ft.	Sacks cement	Shots per ft.	Size & type	Depth interval

TUBING RECORD					
Size	Setting depth	Packer set at			