

15-197-00085
FORM 51 10M 2-49 PETROL

KANSAS


Wabaunsee

O.W.W.O.

Section 11 Township 13 Range 12-E

Well No. #1 Waugh

Company Waugh Bros et al
Veeder et al AIF Landon et al
Wildcat

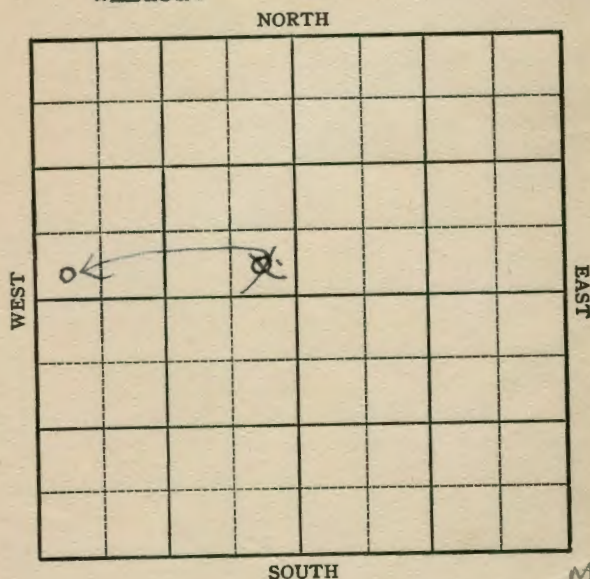

SOUTH

M

FORM 252-A
5M 10-48 PETROL

O.W.W.O.

KANSAS


Wabaunsee

Sec. 11 Twp. 13 R. 12E

Well No. 1 Waugh

Veeder et al AIF Landon et al

Wildcat Waugh Bros et al Contr. Veeder

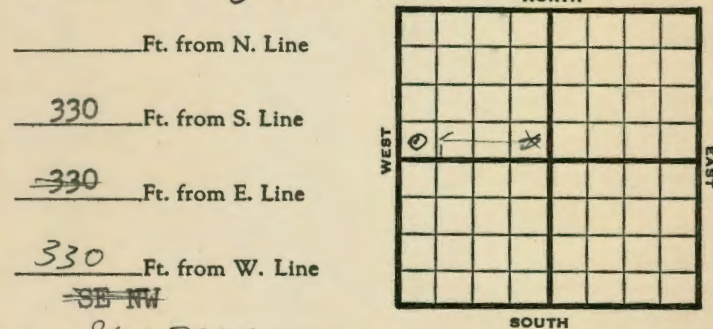

Ft. from N. Line

330 Ft. from S. Line

330 Ft. from E. Line

330 Ft. from W. Line

SE NW

SW NW

1949 **Elev 1175'** REPORT

8/24 Location
8/31 10" @ 115'
9/7 Lansing 1158'
KC 1311'
BKC 1512'
Burgess 2222'
Miss 2233'
Drlg. 2282'
9/14 Hunton 2929' ✓
Simpson shale 3026'
Drlg 3051'
9/21 TD 3142'
Arb. 3091'
Aband.

ABANDONED

1952

O.W.W.O.

5/14 KC 1311 BKC 1512 Miss 2233
Kh 2568 Hunton 2740 Maq 2845
Viola 2929 Simp 3026 Arb. 3091
TD 3142 To test & Hydraf Simp
5/28 D & A TD 3142' KC 1311' BKC 1512'
Miss. 2233', Kh. 2568', Hunton 2740'
Maq. 2845', Viola 2929' Simp 3026'
Arb. 3091' TD 3142' 4" @ 3142'
Pipe parted @ 1800'
D & A

ABANDONED

KC 1311 B KC 1512 Miss. 2233
Kh. 2568 Hunton 2740 Maq. 2845
Viola 2929 Simp. 3026 Arb. 3091
TD 3142 to test & Hydro. Simp.

J. G. McGEHEE

Drig. Data	D & A	TD 3142
KC 1311	B KC 1512	Miss. 2233 Kh. 2560
Hunton 2740	Maq. 2845	Viola 2929
Simp. 3026	Arb. 3091	TD 3142
4" @ 3142	pipe parted @ 1800	
	D & A	

J. G. McGEHEE

Map No. K99 Sec. 11 Twp. 13 R. 12E

Well No. 1 Waugh

Alf Landon etal. Company

ABANDONED Contractor

SW NW

E1.1175
SECTION PLAT

 Ft. from N. Line

330 Ft. from S. Line

 Ft. from E. Line

330 Ft. from W. Line

Wabaunsee County

Location

Rig up

Drilling and Remarks:

Cur 83091

RECORD

Cased in, ft.

Sand

Gas

Oil

Total Depth 3142

PRODUCTION

1st 24 hrs. Nat.

1st 24 hrs. after shot

Gas Cu. Ft.

Dry Hole

Abandoned

Date

SEP 21 1949

19

S. J. LEWIS

Scout

Map No. Sec. 11 Twp. 13 R. 12E

Well No. 1 Waugh

Alf Landon etal. Company

CORRECTION Contractor

SW NW

SECTION PLAT

 Ft. from N. Line

330 Ft. from S. Line

 Ft. from E. Line

330 Ft. from W. Line

Wabaunsee County

Location

Rig up

Drilling and Remarks:

Reported

Veeder Supply
etal.

SE NW

RECORD

Cased in, ft.

Sand

Gas

Oil

Total Depth

PRODUCTION

1st 24 hrs. Nat.

1st 24 hrs. after shot

Gas Cu. Ft.

Dry Hole

Abandoned

Date

SEP 7 1949

19

S. J. LEWIS

Scout

Map No. _____ Sec. 11 Twp. 13 R. 12E

Well No. 1 Waugh

Veeder et al.

Company

Veeder

Contractor

SE NW

FIRST REPORT
SECTION PLAT

Ft. from N. Line


330

Ft. from S. Line

330

Ft. from E. Line

Ft. from W. Line

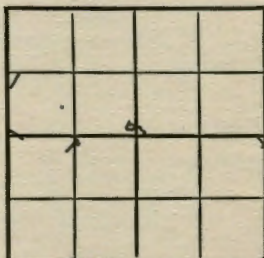

Wabaunsee County

Location X

Rig up

Drilling and Remarks:

RECORD

Cased _____ in., _____ ft.

Sand _____

Gas _____

Oil _____

Total Depth _____

PRODUCTION

1st 24 hrs. Nat. _____

1st 24 hrs. after shot _____

Gas _____ Cu. Ft.

Dry Hole _____

Abandoned _____

Date

AUG 24 1949 19

S. J. LEWIS

Scout