

Shawnee

KANSAS

Sec. 5 Twp. 13 R. 17 E

Well No. # 1 Warner Farm

J. J. Lynn Company

Lindas Contractor

Wildcat


Ft. from N. Line

330 Ft. from S. Line

990 Ft. from E. Line

Ft. from W. Line

SW SE NW

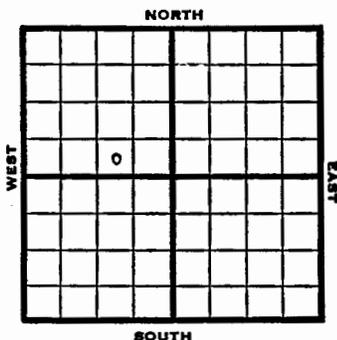

Shawnee


KANSAS

Section 5 Township 13 Range 17E

Well No. 1 Warner

Company J. J. Lynn

NORTH

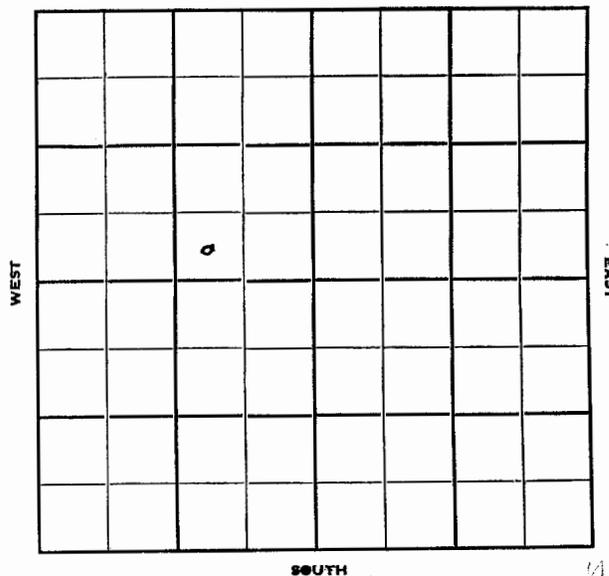

1951 Elev. 1122' REPORT

7/18 Location

8/8  
 D&A TD 2433  
 Bart sand 1681-1705  
 KC 750 BKC 965  
 Miss 1756 Kh 1958  
 Hunton 2040 Viola 2152  
 Simp. 2287 Arb. 2346-2433 TD  
 D&A

**ABANDONED**

