


Map No. **KANSAS** Sec. 11 Twp. 13 S R. 2 EWell No. 1- Poor County FarmAtlas Pub Company

NORTH

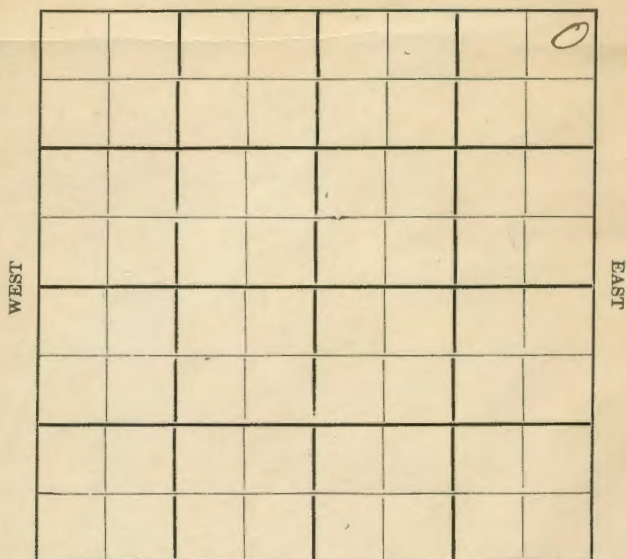

SOUTH

Location
Drilling RemarksRig Up
Drilling Remarks

RECORD

Cased in ft.

Sand

Gas

Oil

Total Depth

PRODUCTION

1st 24 hrs. Nat.

1st 24 hrs. after shot

Gas cu. ft.

Dry Hole

Abandoned

Map No. Sec. Twp. R.

Well No. Farm

Company


NORTH

Ft. from N. Line

Ft. from S. Line

Ft. from E. Line

Ft. from W. Line

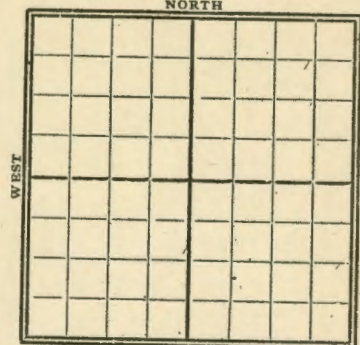

SOUTH

Date

REPORT

1918

Gypsy Record

9/18

Abd TD 2860'

MAP No. _____ SEC. 11 TWP. 13S R. 7EWELL No. 1 Poor / County farmAtlas Pet COMPANY

CONTRACTOR

SECTION PLAT

*Our well map
don't cover*

_____ FT. FROM N. LINE

_____ FT. FROM S. LINE

_____ FT. FROM E. LINE

_____ FT. FROM W. LINE

LOCATION ☒

RIG UP _____

DRILLING AND REMARKS:

RECORD

CASED _____ IN. _____ FT.

SAND _____

GAS _____

OIL _____

TOTAL DEPTH 2860

PRODUCTION

1ST 24 HRS. NAT. _____

1ST 24 HRS. AFTER SHOT _____

GAS _____ CU. FT.

DRY HOLE _____

ABANDONED ☒

DATE

9/18 1918 _____ SCOUT