

14-13-206

STATE CORPORATION COMMISSION OF KANSAS
OIL & GAS CONSERVATION DIVISION
WELL COMPLETION OR RECOMPLETION FORM
ACO-1 WELL HISTORY
DESCRIPTION OF WELL AND LEASE

API NO. 15-045-20,911
County Douglas
NW NW SE NE 14 Twp 13 Rge 20 East West

Operator: License # 6142
Name Town Oil Co.
Address Rt. 4 Paola, KS. 66071
City/State/Zip

2750 Ft North from Southeast Corner of Section
2050 Ft West from Southeast Corner of Section
(Note: Locate well in section plat below)

Purchaser Enron Oil Trading Co.

Lease Name John Gage Well # H-7

Operator Contact Person Lester Town
Phone 913 294-2125

Field Name Bartlesville

Producing Formation Bartlesville

Contractor: License #
Name

Elevation: Ground KB

Wellsite Geologist
Phone

Designate Type of Completion
 New Well Re-Entry Workover

Oil SWD Temp Abd
 Gas Inj Delayed Comp.
 Dry Other (Core, Water Supply etc.)


If OWWO: old well info as follows:
Operator
Well Name
Comp. Date Old Total Depth

Drilling Method:
 Mud Rotary Air Rotary Cable

12-13-85 12-17-85 12-17-85
Spud Date Date Reached TD Completion Date
660
Total Depth P3TD

Amount of Surface Pipe Set and Cemented at 51 feet
Multiple Stage Cementing Collar Used? Yes No
If yes, show depth set feet
If alternate 2 completion, cement circulated from 0 feet depth to 51 w/ 8 SX cmt
Cement Company Name Consolidated
Invoice # 59564

Section Plat

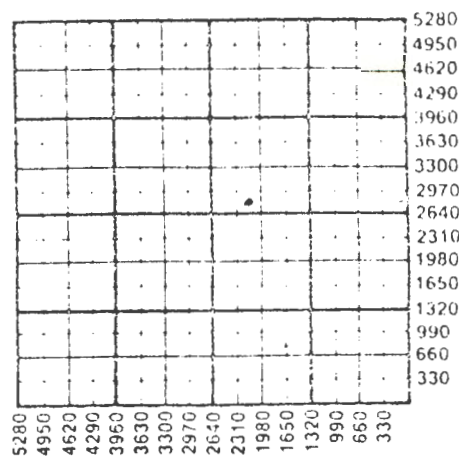

WATER SUPPLY INFORMATION

Disposition of Produced Water: Disposal
Docket # Repressuring

Questions on this portion of the ACO-1 call:
Water Resources Board (913) 296-3717

Source of Water:
Division of Water Resources Permit #
Groundwater Ft North from Southeast Corner (Well) Ft West from Southeast Corner of Sec Twp Rge East West
Surface Water Ft North from Southeast Corner (Stream, pond etc.) Ft West from Southeast Corner Sec Twp Rge East West
Other (explain)
(purchased from city, R.W.D. #)

INSTRUCTIONS: This form shall be completed in triplicate and filed with the Kansas Corporation Commission, 200 Colorado Derby Building, Wichita, Kansas 67202, within 120 days of the spud date of any well. Rule 82-3-130, 82-3-107 and 82-3-106 apply. Information on side two of this form will be held confidential for a period of 12 months if requested in writing and submitted with the form. See rule 82-3-107 for confidentiality in excess of 12 months. One copy of all wireline logs and drillers time log shall be attached with this form. Submit CP-4 form with all plugged wells. Submit CP-111 form with all temporarily abandoned wells.

14-13-20 E

Operator Name Town Oil Co. Lease Name John Gage Well # H-7

Sec. 14 Twp. 13 Rge. 20 East West County Douglas

WELL LOG

INSTRUCTIONS: Show important tops and base of formations penetrated. Detail all cores. Report all drill stem tests giving interval tested, time tool open and closed, flowing and shut-in pressures, whether shut-in pressure reached static level, hydrostatic pressures, bottom hole temperature, fluid recovery, and flow rates if gas to surface during test. Attach extra sheet if more space is needed. Attach copy of log.

Drill Stem Tests Taken Yes No
 Samples Sent to Geological Survey Yes No
 Cores Taken Yes No

Formation Description
 Log Sample

Name Top Bottom

See attached log

CASING RECORD <input checked="" type="checkbox"/> New <input type="checkbox"/> Used							
Report all strings set-conductor, surface, intermediate, production, etc.							
Purpose of String	Size Hole Drilled	Size Casing Set (in O.D.)	Weight Lbs/Ft.	Setting Depth	Type of Cement	#Sacks Used	Type and Percent Additives
Surface Completion	9 5 1/8	6 1/2 2 1/2		51 646	Portland	8 69	60/40 Poz.
PERFORATION RECORD				Acid, Fracture, Shot, Cement Squeeze Record (Amount and Kind of Material Used) Depth			
Shots Per Foot	Specify Footage of Each Interval Perforated						
2	621-629			H ₂ O acid 25% acid			6.50
TUBING RECORD				Liner Run <input type="checkbox"/> Yes <input type="checkbox"/> No			
Date of First Production		Size <u>1"</u> Set At <u>625</u>		Packer at			
<u>1-86</u>		Producing Method		<input type="checkbox"/> Flowing <input checked="" type="checkbox"/> Pumping <input type="checkbox"/> Gas Lift <input type="checkbox"/> Other (explain).....			