

35-13-20E

STATE CORPORATION COMMISSION OF KANSAS
OIL & GAS CONSERVATION DIVISION

WELL COMPLETION OR RECOMPLETION FORM
ACO-1 WELL HISTORY

DESCRIPTION OF WELL AND LEASE

Operator: license # 9203
name Rolex, Inc.
address 932 Massachussetts
City/State/Zip Lawrence, Kansas 66044

Operator Contact Person Pat Haley
Phone (213) 254-3232

Contractor: license # 8509
name Gault Energy Corp.

Wellsite Geologist Pat Haley
Phone (213) 254-3232

PURCHASER... Square Deal

Designate Type of Completion
 New Well Re-Entry Workover

- Oil SWD Temp Abd
- Gas Inj Delayed Comp.
- Dry Other (Core, Water Supply etc.)

If OWWO: old well info as follows:
Operator
Well Name
Comp. Date Old Total Depth

WELL HISTORY

Drilling Method: Mud Rotary Air Rotary Cable
5/25/84 5/30/84 6/26/84
Spud Date Date Reached TD Completion Date
715
Total Depth PBD

Amount of Surface Pipe Set and Cemented at 100 feet

Multiple Stage Cementing Collar Used? Yes No

If Yes, Show Depth Set feet

If alternate 2 completion, cement circulated
from surface feet depth to 100 w/ 70 SX cmt

API NO. 15 - 045-20-566

County Douglas

NE/4 NW NW NE (NAD 83 KGS DEL 2022)
35 13 20 X East
(location) Sec Twp Rge West

5115 Ft North from Southeast Corner of Section
2145 Ft West from Southeast Corner of Section
(Note: locate well in section plat below)


Lease Name Dean Well# 2

Field Name New Field

Producing Formation Squirrel

Elevation: Ground 870 KB

Section Plat

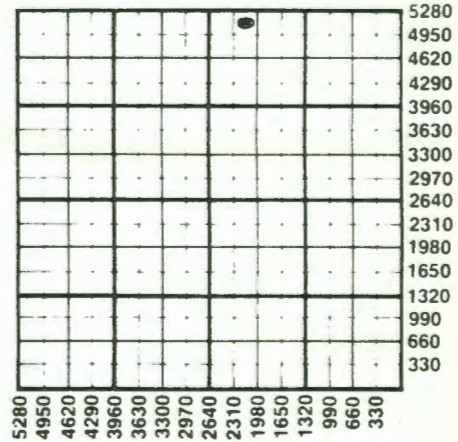

* WATER SUPPLY INFORMATION

Source of Water:
Division of Water Resources Permit #
 Groundwater... Ft North From Southeast Corner and
(Well) ... Ft West From Southeast Corner of
Sec Twp Rge East West
 Surface Water... Ft North From Southeast Corner and
(Stream, Pond etc.) ... Ft West From Southeast Corner
Sec Twp Rge East West
 Other (explain) Kramer Oil Field Service, Inc.
(purchased from city, R.W.D.#)

Disposition of Produced Water: Disposal Repressuring

Docket #

RECEIVED

TUBING RECORD

size set at packer at Liner Run Yes No

Date of First Production 6/26/84
Producing method flowing pumping gas lift Other (explain)

Estimated Production Per 24 Hours	Oil	Gas	Water	Gas-Oil Ratio	Gravity
	2 Bbls	---	MCF	Rbls	CFBR

Operator Name Rolex, Inc. Lease Name Dean Well# 2 SEC 35 TWP. 13 RGE. 20 East West

WELL LOG

INSTRUCTIONS: Show important tops and base of formations penetrated. Detail all cores. Report all drill stem tests giving interval tested, time tool open and closed, flowing and shut-in pressures, whether shut-in pressure reached level, hydrostatic pressures, bottom hole temperature, fluid recovery, and flow rates if gas to surface during test. Attach extra sheet if more space is needed. Attach copy of log.

Drill Stem Tests Taken Yes No
 Samples Sent to Geological Survey Yes No
 Cores Taken Yes No

Formation Description
 Log Sample

Core #1 671-690

Name	Top	Bottom
Shale	664	670
Lime	670	671
Shale	671	673
Lime	673	674
Shale	674	676
Sandy Shale	676	682
Sand	682	688
Sandy Shale	688	745
		T.D.

Name	Top	Bottom
Lime	0	364
Shale	364	365
Lime	365	373
Shale	373	381
Lime	381	404
Shale	404	40'
Lime	406	422
Shale	422	427
Lime	427	428
Sandy Shale	428	436
Shale	436	46'
Lime	468	465
Sandy Shale	469	539
Hard Sand	539	543
Sandy Shale	543	561
Lime	561	563
Sandy Shale	563	569
Lime	569	571
Shale	571	57
Lime	573	574
Sandy Shale	574	588
Lime	588	595
Shale	595	598
Lime	598	601
Slate	601	605
Shale	605	608
Lime	608	613
Shale	613	6
Lime	618	621
Shale	621	630
Lime	630	652
Shale	652	662
Lime	662	6'

CASING RECORD new used

Report all strings set - conductor, surface, intermediate, production, etc.

Purpose of string	size hole drilled	size casing set (in O.D.)	weight lbs/ft.	setting depth	type of cement	# sacks used	type and percent additives
surface	10"	7"	16 1/2	100	Portland	70	2% gel
production	6"	2 7/8	6.7	715	Portland	105	2% gel

PERFORATION RECORD

Acid, Fracture, Shot, Cement Squeeze Record

shots per foot	specify footage of each interval perforated	(amount and kind of material used)	Depth
2	679-685	sand/oil frac 6000# & 80 Bbls	679-685

METHOD OF COMPLETION

PRODUCTION INTERVAL

Disposition of gas: vented
 sold
 used on lease

open hole perforation
 other (specify) _____
 Dually Completed.